

A

BOARD OF WATER COMMISSIONERS
416 North State Street
Jackson, Mississippi 39201

WATER WELL DRILLERS LOG

date well completed

19 Large Well Supply
firm name

Yalobamba
county well located

LANDOWNER: Holloway Homes

description of formations encountered

from

to

top soil clay
Red sand

0 16
10 13

(mailing address)

clay

13 16

WELL LOCATION:

SAND

16 41

sec. 19 T. 11 N R. 1 E
5 miles S of Silverton
(distance) (direction) (nearest town)

Rock

44 42

clay

42 58

SAND

58 200

WELL PURPOSE: home
(home, irrigation, municipal, industrial)

WELL COMPLETION DATA:

- (1) diameter (inches) 4
- (2) total depth (feet) 200
- (3) static water level (feet) 80 below above top of ground.

(4) casing PVC
(material) (depth)
(size) if telescope see back.

(5) screen 8 192
(length) (depth to top)
4 PVC
(size) (material)

(6) pump 3/4 10
(HP) (yield gpm)
elec
(type power)

(7) electric log NO
(yes or no)

(organization running log)

(8) how well bottom plugged PVC cap

DRILLERS REMARKS:


DEPT. OF NATURAL RESOURCES
BUREAU OF LAND & WATER RESOURCES

SEP 29 1983

RECEIVED

If well telescopes please sketch and show depths.

GROUND LEVEL

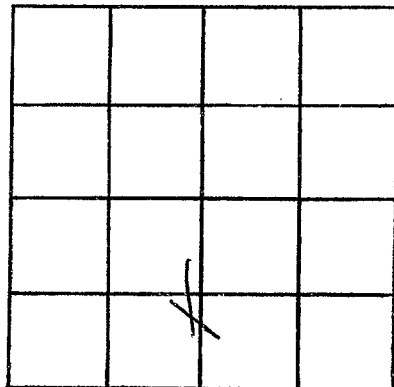

SECTION _____

Please indicate well location X.

ADDITIONAL INFORMATION

If more than one screen, show locations of each on sketch.