

**MISSISSIPPI
BOARD OF WATER COMMISSIONERS
416 North State Street
Jackson, Mississippi 39201**

WATER WELL DRILLERS LOG

Jan 74 19 LIPE WELL & SUPPLY CO., INC. YALOBUSHA
date well completed firm name county well located

LANDOWNER:	description of formations encountered	from	to
<u>COCONA RIDGE STATE PARK</u>			
<u>OAKLAND, MISSISSIPPI</u> (mailing address)	<u>HARD SHALE</u>	<u>820</u>	<u>840</u>
<u>WELL LOCATION:</u> <u>sec 15 T 28 N R 6 E</u> <u>5 miles East of OAKLAND</u> (distance) (direction) (nearest town)	<u>HARD SHALE</u>	<u>840</u>	<u>860</u>
<u>WELL PURPOSE: TEST</u> (home, irrigation, municipal, industrial)	<u>HARD SHALE</u>	<u>860</u>	<u>880</u>
<u>WELL COMPLETION DATA:</u>	<u>HARD SHALE</u>	<u>880</u>	<u>900</u>
(1) diameter (inches) <u>8"</u>	<u>HARD SHALE</u>	<u>900</u>	<u>920</u>
(2) total depth (feet) <u>1150'</u>	<u>HARD SHALE</u>	<u>920</u>	<u>940</u>
(3) static water level (feet) _____ below above top of ground.	<u>HARD SHALE</u>	<u>940</u>	<u>960</u>
(4) casing <u>STEEL</u> <u>4 1/2"</u> (material) (depth)	<u>X-HARD SHALE</u>	<u>960</u>	<u>980</u>
<u>4"</u> if telescope see back. (size)	<u>X-HARD SHALE</u>	<u>980</u>	<u>1000</u>
(5) screen <u>24"</u> <u>666'</u> (length) (depth to top)	<u>HARD SHALE</u>	<u>1000</u>	<u>1020</u>
<u>2"</u> <u>S.S.</u> (size) (material)	<u>HARD SHALE</u>	<u>1020</u>	<u>1040</u>
(6) pump <u>5</u> <u>35</u> (HP) (yield gpm)	<u>HARD SHALE</u>	<u>1040</u>	<u>1060</u>
<u>ELEC.</u> (type power)	<u>HARD SHALE</u>	<u>1060</u>	<u>1080</u>
(7) electric log <u>YES</u> (yes or no)	<u>HARD SHALE</u>	<u>1080</u>	<u>1100</u>
<u>U.S.G.S.</u> (organization running log)	<u>HARD SHALE</u>	<u>1100</u>	<u>1120</u>
(8) how well bottom plugged <u>PLUG</u>	<u>HARD SHALE</u>	<u>1120</u>	<u>1140</u>
<u>DRILLERS REMARKS:</u>			


**REGISTERED
INSTRUMENT
JAN - 8 1974**

**LIPE WELL & SUPPLY CO., INC.
LARRY LIPE, VICE PRESIDENT**

MISS. BD. OF WATER COMMISSIONERS

If well telescopes please sketch and show depths.

GROUND LEVEL

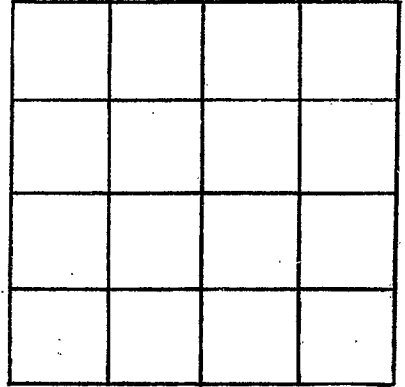

SECTION _____

Please indicate well location X.

ADDITIONAL INFORMATION

If more than one screen, show locations of each on sketch.