

YALOB. A 7

CODED WATER WELL DRILLER

9-17-62

YALOBUSHA

Date: 9/17, 1962, Driller: James R. Lipe

(Name)

CODED

(1) Owner of Land: Johnny Conners (Name) OAKLAND, Miss. (Address)

(2) Location: 1/4, 1/4, Sec 34 26 6 NW 1/4 4 miles east of Oakland (direction) (Nearest Town)

(3) Topography: Hilly (Hilly) (Flat) (Level)

(4) Purpose of Well: Domestic (Domestic Irrigation Municipal, Industrial, Other)

Description & Color of Materials Sand, Clay, Red Clay, Shell, etc.

Thickness Feet

Depth Feet

CLAY	0	20
sand & CLAY	20	30
GRAVEL	50	70
GRAVEL & SAND	70	90
W/pebbles Sand	90	114


Information upon completion of well:

- (1) Diameter 2 inches.
- (2) Total Depth 114' feet.
- (3) Water Level 80' feet below top of ground.
- (4) Cased to 105', Size 2"
- (5) Screen: Size 1/4, Length 6'
- (6) Were any formations sealed against pollution? yes, no.

If YES depth of formation

Why

Drillers Remarks:

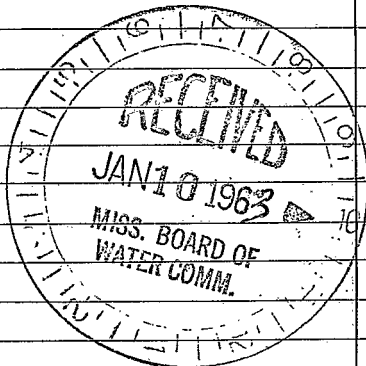

(Use Back Side)

Well No.

