

A 9
5-24-66

James Ray Lyle
WATER WELL DRILLERS LOG

Jalobusha

Date: 5-24, 1966, Driller: Frank Lyle County: Veneta
(Name)

(1) Owner of Land: Ambell
(Name)
Oakland
(Address)

(2) Location: $\frac{1}{4}$, $\frac{1}{4}$, Sec. 36 ²⁶ _N ⁶ _W
11 miles east of Oakland
(distance) (direction) (Nearest Town)

(3) Topography: Hilly
(Hilly) (Flat) (Level)

(4) Purpose of Well: Domestic
(Domestic Irrigation
Municipal, Industrial, Other)

Description & Color of Materials Sand, Clay, Red Clay, Shell, etc.	Thick- ness Feet	Depth Feet
<u>Clay</u>	<u>0</u>	<u>25</u>
<u>Clay & gravel</u>	<u>25</u>	<u>40</u>
<u>Gravel & Sand</u>	<u>40</u>	<u>60</u>
<u>Red sand</u>	<u>60</u>	<u>84</u>

Information upon completion of well:

(1) Diameter 4" inches.

(2) Total Depth 84' feet.

(3) Water Level 50 feet below top of ground.

(4) Cased to 78, Size 4"


(5) Screen: Size 4", Length 4'

(6) Were any formations sealed against pollution?
_____ yes, _____ no.

If YES depth of formation _____

Why _____

Drillers Remarks: _____

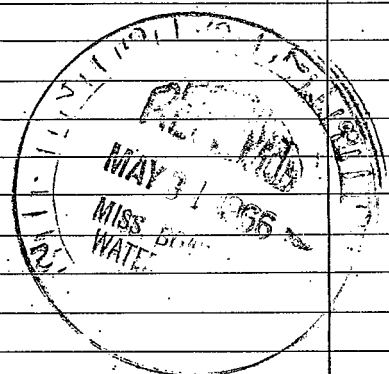

(Use Back Side)

Well No.

