

J. B. Cain

MISSISSIPPI  
BOARD OF WATER COMMISSIONERS  
416 North State Street  
Jackson, Mississippi 39201

CODED

CODED

WATER WELL DRILLERS LOG

date well completed 19 9-1-68 firm name Yalobusha county well located Yalobusha

LANDOWNER Mr W C Vinson

Description of formations encountered

from to

Sambert Mine

Sky of  
Bluff of  
Sand

0 80  
80 180  
180 250

(mailing address)

WELL LOCATION:


sec. 14 26 N 9 R 11 E 6 W  
S 6 W  
10 miles E of OKland  
(distance) (direction) (nearest town)

WELL PURPOSE:

(home, irrigation, municipal, industrial)

WELL COMPLETION DATA:


- (1) diameter (inches) 4"
- (2) total depth (feet) 250
- (3) static water level (feet) 90 below above top of ground.
- (4) casing Plastic 240  
(material) (depth)
- \_\_\_\_\_ If telescope see back.  
(size)
- (5) screen 10' 240  
(length) (depth to top)
- 2 Plastic  
(size) (material)
- (6) pump 3/4 12  
(HP) (yield gpm)
- Electric  
(type power)
- (7) electric log no  
(yes or no)
- \_\_\_\_\_ (organization running log)
- (8) how well bottom plugged Wash Blaine

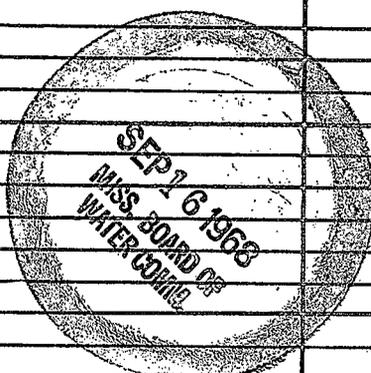

DRILLERS REMARKS:

If well telescopes please sketch and show depths.

GROUND LEVEL

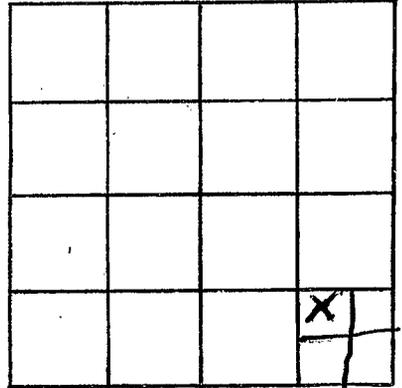

SECTION 14

Please indicate well location X.

ADDITIONAL INFORMATION

If more than one screen,  
show location's of each on sketch.