

YALOBUSHA  
A 15  
4-68

MISSISSIPPI  
BOARD OF WATER COMMISSIONERS  
416 North State Street  
Jackson, Mississippi 39201

CODED  
CODED  
CODED

WATER WELL DRILLERS LOG

4-28 1968 date well completed  
J. B. Cain firm name  
Yalobusha county well located

LANDOWNER: MR. HAMBY  
OKLAND MISS

description of fomations encountered	from	to
Sand	0	60
Brk of Sand	60	80
Sand	80	130


(mailing address)

WELL LOCATION:  
sec 13 T 26 N R 6 E  
S W  
4 miles NE of OKLAND  
(distance) (direction) (nearest town)

WELL PURPOSE: CAIN  
(home, irrigation, municipal, industrial)

- WELL COMPLETION DATA:
- (1) diameter (inches) 2"
  - (2) total depth (feet) 130
  - (3) static water level (feet) 88 below top of ground
  - (4) casing Plastic 130 (material) (depth)  
2" if telescope see back. (size)
  - (5) screen 5 125 (length) (depth to tap)  
2" Shale Prob (size) (material)
  - (6) pump 1 1/2 6 (HP) (yield gpm)  
Electric (type power)
  - (7) electric log No (yes or no)
  - (8) how well bottom plugged Plug

DRILLERS REMARKS:

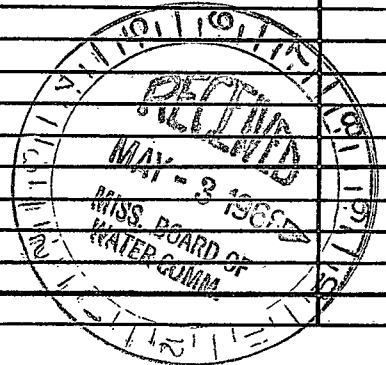

If well telescopes please sketch and show depths.

GROUND LEVEL

			X

SECTION 13

Please indicate well location X.

ADDITIONAL INFORMATION

If more than one screen, show locations of each on sketch.