

ALCO.
A 18
9-20-62
9-20-62

MISSISSIPPI BOARD OF WATER COMMISSIONERS

WATER WELL DRILLER'S LOG

CODED

J B CAIN

10/3/62

Date: _____, 19____, Driller: _____ County _____
(Name)


(1) Owner of Land: Albert Giffin
(Name)
Erub Murr
(Address)
(2) Location: 1/4, 3 25 7W T R
8 SE Pope
miles _____, of _____
(distance) (direction) (Nearest Town)
(3) Topography: _____
(Hilly) (Flat) (Level)
(4) Purpose of Well: Home
(Domestic Irrigation
Municipal, Industrial, Other)

Description & Color of Materials Sand, Clay, Red Clay, Shell, etc.	Thick- ness Feet	Depth Feet
<u>Clay</u>	<u>20</u>	<u>20</u>
<u>grt</u>	<u>20</u>	<u>60</u>
<u>Sand</u>	<u>60</u>	<u>80</u>

Information upon completion of well:

(1) Diameter 2 inches.
(2) Total Depth 80 feet.
(3) Water level 70 feet below top of ground.
(4) Cased to 80 Size 2"
(5) Screen: Size 1 1/4 Length 6 FT
(6) Were any formations sealed against pollution?
_____ yes, _____ no.

If YES depth of formation _____
Why _____
Drillers Remarks: _____

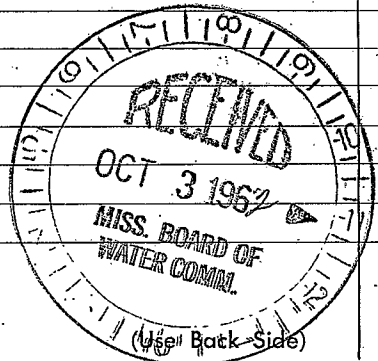

Well No.

