

MISSISSIPPI
BOARD OF WATER COMMISSIONERS
416 North State Street
Jackson, Mississippi 39201

CODED

WATER WELL DRILLERS LOG

| |
|-----------|
| YALOBUSHA |
| A 19 |
| 8-19-70 |

Aug 18 1970 Lipe Well Co. Yalobusha
date well completed firm name county well located

LANDOWNER: Allen
Oakland Miss.
(mailing address)

| description of formations encountered | from | to |
|---------------------------------------|------|-----|
| Clay | 0 | 20 |
| ll | 20 | 40 |
| Sand | 40 | 60 |
| ll | 60 | 80 |
| ll | 80 | 100 |

WELL LOCATION:
sec. 36 T. 12 N. R. 6 E.
4 miles East of Oakland
(distance) (direction) (nearest town)

WELL PURPOSE: home
(home, irrigation, municipal, industrial)

WELL COMPLETION DATA:

(1) diameter (inches) 4

(2) total depth (feet) 100

(3) static water level (feet) 90 below top of ground.

(4) casing PVC 90
(material) (depth)

4 If telescope see back.
(size)

(5) screen 10 90
(length) (depth to top)

4 PVC
(size) (material)

(6) pump 1/2 20
(HP) (yield gpm)

Elec.
(type power)

(7) electric log no
(yes or no)

no
(organization running log)

(8) how well bottom plugged PVC
plug

CODED


AUG 24 1970

DRILLERS REMARKS:

MISS. RE. OF
WATER

If well telescopes please sketch and show depths.

GROUND LEVEL

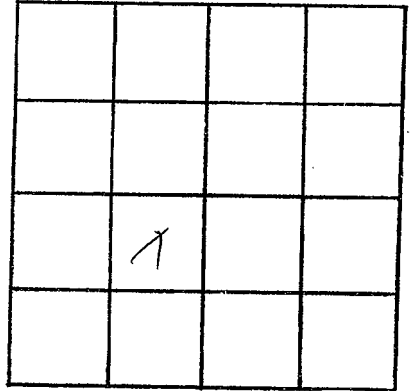

SECTION 36

Please indicate well location X.

ADDITIONAL INFORMATION

Lined area for additional information.

If more than one screen, show locations of each on sketch.