

MISSISSIPPI
BOARD OF WATER COMMISSIONERS
416 North State Street
Jackson, Mississippi 39201

CODED

WATER WELL DRILLERS LOG

YALOBUSTHA
A 23
6-20-71

6-20 19**71** *Suttons Well Dr.* *Yalobusha*
date well completed firm name county well located

LANDOWNER: ~~John~~

description of formations encountered from to

Max Bernice Moore
Oakland, Miss.
(mailing address)

<i>Red Clay</i>	<i>1</i>	<i>18</i>
<i>Travel</i>	<i>18</i>	<i>20</i>
<i>Red 1 clay + 3 sand</i>	<i>20</i>	<i>38</i>
<i>CR 2 Vel</i>	<i>38</i>	<i>40</i>
<i>Gr 1 White Sand</i>	<i>40</i>	<i>70</i>
<i>Gravel Sand</i>	<i>70</i>	<i>80</i>
<i>CR 2 Vel</i>	<i>80</i>	<i>81</i>
<i>Water Sand</i>	<i>81</i>	<i>91</i>

WELL LOCATION:
sec. 34 T. 26 N. R. 4 E.
S
3 miles NE of OAKLAND
(distance) (direction) (nearest town)

WELL PURPOSE: *Home*
(home, irrigation, municipal, industrial)

WELL COMPLETION DATA:

- (1) diameter (inches) 2"
- (2) total depth (feet) 91'
- (3) static water level (feet) 80' below above top of ground.
- (4) casing 9" steel, 86',
(material) (depth)
2" if telescope see back.
(size)
- (5) screen 5', 5 1/2'
(length) (depth to top)
1 1/4", SS CRUZER
(size) (material)
- (6) pump 3/4, 4
(HP) (yield gpm)
Electric
(type power)
- (7) electric log No
(yes or no)

CODED

(organization running log)

(8) how well bottom plugged: *plug part*


DRILLERS REMARKS:

JUL 15 1971

MISS. BD. OF
WATER COMM.

If well telescopes please
sketch and show depths.

GROUND LEVEL

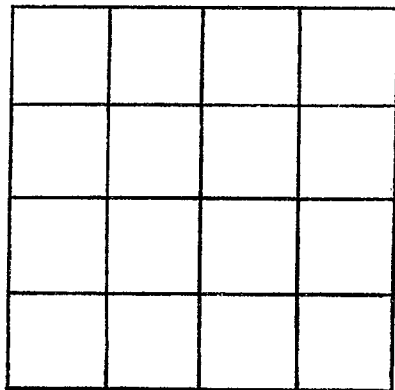

SECTION _____

Please indicate well location X.

ADDITIONAL INFORMATION

If more than one screen,
show locations of each on sketch.