

Yalobusha
A 25
7-12-71

MISSISSIPPI
 BOARD OF WATER COMMISSIONERS
 416 North State Street
 Jackson, Mississippi 39201

WATER WELL DRILLERS LOG

July 12 1971 Pepe Well Co. **CODED**
 date well completed firm name country well located

LANDOWNER:
Donnie Tippit
Pepe, Miss
 (mailing address)

description of formations encountered	from	to
<u>top soil</u>	<u>0</u>	<u>5</u>
<u>sand and gravel</u>	<u>3</u>	<u>40</u>
<u>sand</u>	<u>40</u>	<u>130</u>

WELL LOCATION:
 sec. 3 T 26 (N) R. 7 E
4 miles S of Pepe
 (distance) (direction) (nearest town)

WELL PURPOSE: Dom
 (home, irrigation, municipal, industrial)

- WELL COMPLETION DATA:
- (1) diameter (inches) 4"
 - (2) total depth (feet) 127
 - (3) static water level (feet) 60 below above top of ground.
 - (4) casing PVC 119
 (material) (depth)
4"
 (size) if telescope see back.
 - (5) screen 8 119'
 (length) (depth to top)
4" PVC & silica
 (size) (material)
 - (6) pump 3/4 10
 (HP) (yield gpm)
elec.
 (type power)
 - (7) electric log no
 (yes or no)
 (organization running log)
 - (8) how well bottom plugged PVC cap

CODED


NOV 12 1971

DRILLERS REMARKS:

MISSISSIPPI BOARD OF WATER COMMISSIONERS

If well telescopes please sketch and show depths.

GROUND LEVEL

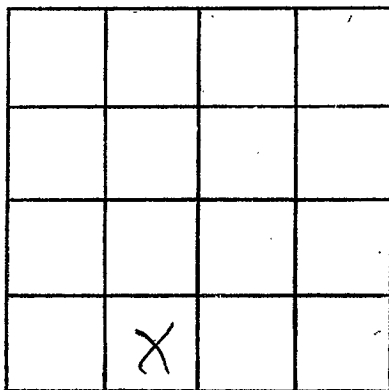

SECTION 3

Please indicate well location X.

ADDITIONAL INFORMATION

Lined area for additional information.

If more than one screen, show locations of each on sketch.