

**YALOBUSHA**  
**A 27**  
**9-15-72**

MISSISSIPPI  
 BOARD OF WATER COMMISSIONERS  
 416 North State Street  
 Jackson, Mississippi 39201

**CODED**

**WATER WELL DRILLERS LOG**

9-15 date well completed      722 James Blip firm name      Yalobusha county well located

LANDOWNER:  
 Mrs. Ivy Price  
 Pope Miss.  
 (mailing address)

description of formations encountered	from	to
Clay	0	20
Sand	20	40
	40	54

WELL LOCATION:  
 sec. 18 T 26 N R 4 E  
 4 miles South of Pope  
 (distance) (direction) (nearest town)

WELL PURPOSE: HOME  
 (home, irrigation, municipal, industrial)

- WELL COMPLETION DATA:
- (1) diameter (inches) 2"
  - (2) total depth (feet) 54
  - (3) static water level (feet) 15' below top of ground.
  - (4) casing PVC, 49' (material) (depth)  
 (size) if telescope see back.
  - (5) screen 5' length, 49' depth to top  
 2" PVC (size) (material)
  - (6) pump 1/2 HP, 8 (yield gpm)  
 Elec. (type power)
  - (7) electric log NO (yes or no)  
 NO (organization running log)
  - (8) how well bottom plugged PVC PLUG

**CODED**


OPT - 2 1972

MISS. Bd. OF WATER COMMISSIONERS

DRILLERS REMARKS:

If well telescopes please sketch and show depths.

GROUND LEVEL

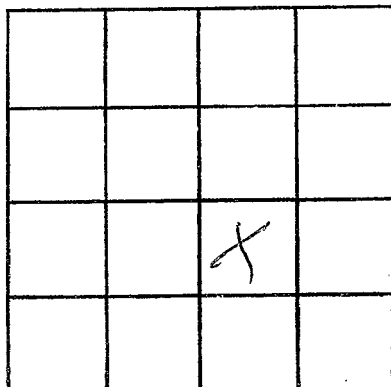

SECTION 18

Please indicate well location X.

ADDITIONAL INFORMATION

If more than one screen, show locations of each on sketch.