

YALOBUSHA
A 29
5-29-73

MISSISSIPPI
BOARD OF WATER COMMISSIONERS
416 North State Street
Jackson, Mississippi 39201

WATER WELL DRILLERS LOG

CODED

5-29 1973 James R. Lipe Yalobusha
date well completed firm name county well located

LANDOWNER:
Lemar Gandy
Water Valley Miss.
(mailing address)

description of formations encountered	from	to
clay	0	20
yellow clay	20	40
sand and clay	40	60
white sand	60	80
li li	80	96

WELL LOCATION:
sec. 13 T 26 N S R 6 E W
8 miles west of W.V.
(distance) (direction) (nearest town)

WELL PURPOSE:
(home, irrigation, municipal, industrial)

WELL COMPLETION DATA:

(1) diameter (inches) 4

(2) total depth (feet) 96

(3) static water level (feet) 30 below top of ground.

(4) casing PVC 88
(material) (depth)
4 (size) if telescope see back.

(5) screen 8 88
(length) (depth to top)
4 PVC
(size) (material)

(6) pump 3/4 12
(HP) (yield gpm)
Elec.
(type power)

(7) electric log no
(yes or no)
no
(organization running log)

(8) how well bottom plugged PVC
plug


CODED

DRILLERS REMARKS:

JUN 7 1973

If well telescopes please sketch and show depths.

GROUND LEVEL

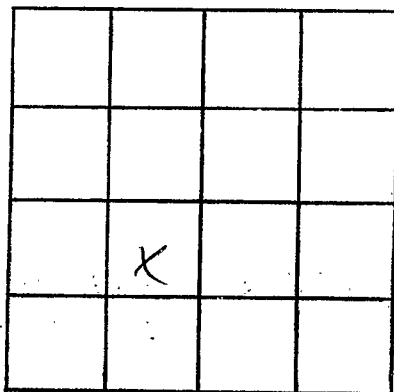

SECTION 13

Please indicate well location X.

ADDITIONAL INFORMATION

If more than one screen,
show locations of each on sketch.