

**YALOBUSHA**  
**A 32**  
**9-18-73**

MISSISSIPPI  
 BOARD OF WATER COMMISSIONERS **CODED**  
 416 North State Street  
 Jackson, Mississippi 39201

**WATER WELL DRILLERS LOG**

19-18 19 93 Life Well Co. Yalobusha  
 date well completed firm name county well located

**LANDOWNER:**  
W. H. McNeel  
ENid Miss.  
 (mailing address)

**WELL LOCATION:**  
 sec. 18 T. 26 N. R. 7 E  
2 miles East of ENid  
 (distance) (direction) (nearest town)

description of formations encountered	from	to
TOP Soil	0	20
CLAY	20	40
Sand	40	60
Gravel	60	80
LL	80	100
Sand and Gravel	100	120
Sand	120	140
LL	140	160
LL	160	175

**WELL PURPOSE:**  
 (home, irrigation, municipal, industrial)

**WELL COMPLETION DATA:**

(1) diameter (inches) 4"

(2) total depth (feet) 175

(3) static water level (feet) 120 below above top of ground.

(4) casing PVC 165,  
 (material) (depth)  
4 if telescope see back.  
 (size)

(5) screen 10, 165  
 (length) (depth to top)  
4, PVC  
 (size) (material)

(6) pump 3/4, 10  
 (HP) (yield gpm)  
elec.  
 (type power)

(7) electric log NO  
 (yes or no)  
NO  
 (organization running log)

(8) how well bottom plugged PVC  
PI 09


**CODED**

**DRILLERS REMARKS:**

**OCT 7 1973**

If well telescopes please sketch and show depths.

GROUND LEVEL

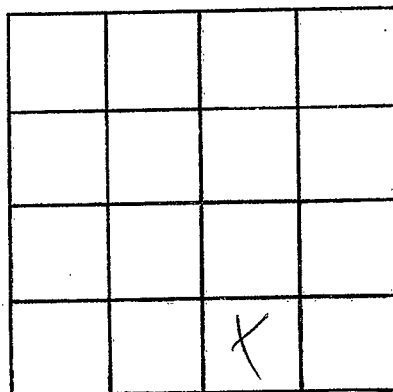

SECTION 18

Please indicate well location X.

ADDITIONAL INFORMATION

If more than one screen, show locations of each on sketch.