

MISSISSIPPI
BOARD OF WATER COMMISSIONERS
416 North State Street
Jackson, Mississippi 39201

WATER WELL DRILLERS LOG

CODED

YALOBUSHA
A33
5-20-74

5-20 1974 Lipe Well Co. Yalobusha
date well completed firm name county well located

LANDOWNER:
Willie H. Dunn
Oakland Miss.
(mailing address)

description of formations encountered	from	to
<u>Top soil</u>	<u>0</u>	<u>25</u>
<u>red sand</u>	<u>20</u>	<u>40</u>
<u>" "</u>	<u>40</u>	<u>60</u>
<u>Gravel</u>	<u>60</u>	<u>80</u>
<u>Clay</u>	<u>80</u>	<u>100</u>
<u>sand and clay</u>	<u>100</u>	<u>120</u>
<u>sand</u>	<u>120</u>	<u>140</u>
<u>cc</u>	<u>140</u>	<u>160</u>


WELL LOCATION:
sec. 19 T 26 N R 6 E
S W
3 miles east of Oakland
(distance) (direction) (nearest town)

WELL PURPOSE:
(home) irrigation, municipal, industrial

- WELL COMPLETION DATA:
- (1) diameter (inches) 4
 - (2) total depth (feet) 160
 - (3) static water level (feet) 60 below above top of ground.
 - (4) casing PVC, 150
(material) (depth)
4 if telescope see back.
(size)
 - (5) screen 10, 150
(length) (depth to top)
4, PVC
(size) (material)
 - (6) pump 3/4, 10
(HP) (yield gpm)
elec
(type power)
 - (7) electric log no
(yes or no)
no
(organization running log)
 - (8) how well bottom plugged PVC
plug

CODED

DRILLERS REMARKS:

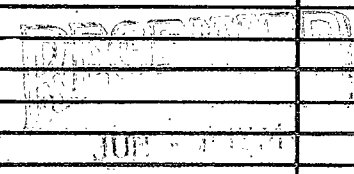

If well telescopes please sketch and show depths.

GROUND LEVEL

X			

SECTION 19

Please indicate well location X.

ADDITIONAL INFORMATION

If more than one screen, show locations of each on sketch.