

YALOBUSHA

A39

7-1-78

EL 58

MISSISSIPPI
 BOARD OF WATER COMMISSIONERS
 416 North State Street
 Jackson, Mississippi 39201

WATER WELL DRILLERS LOG

CODED

7-2-78 date well completed

19

LIPE WELL & SUPPLY CO., INC.

firm name

YALOBUSHA

county well located

LANDOWNER:	description of formations encountered	from	to
YOCOMA RIDGE STATE PARK	TOP SOIL & BED SAND	0	20
OATLAND, MISSISSIPPI (mailing address)	BED SAND & FEA GRAVEL	20	40
WELL LOCATION: sec. 15 T. 26 N. R. 6 W. 5 miles E of OATLAND (distance) (direction) (nearest town)	SAND & WHITE CLAY	40	60
WELL PURPOSE: <u>irrigation</u> (home, irrigation, municipal, industrial)	SAND & WHITE CLAY	60	80
WELL COMPLETION DATA: (1) diameter (inches) <u>8"</u>	SAND & GRAVEL	80	100
(2) total depth (feet) <u>600-1150'</u>	SAND & GUMBO	100	120
(3) static water level (feet) _____ below above top of ground.	SAND & GUMBO	120	140
(4) casing <u>Steel</u> / <u>4 1/2"</u> (material) (depth)	GUMBO & SAND LENS	140	160
<u>8"</u> If telescope see back. (size)	GUMBO & SAND LENS	160	180
(5) screen <u>24"</u> / <u>665'</u> (length) (depth to top)	GUMBO & SAND LENS	180	200
<u>2"</u> / <u>S.S.</u> (size) (material)	SAND	200	220
(6) pump <u>5</u> / <u>55</u> (HP) (yield gpm)	BLUE GUMBO	220	240
<u>1/2 HP</u> (type power)	GUMBO & SAND STREAKS	240	260
(7) electric log <u>yes</u> (yes or no)	SAND & CLAY STREAKS	260	280
<u>U.S.G.S.</u> (organization running log)	SAND - COARSE	280	300
(8) how well bottom plugged <u>PLUG</u>	SAND & COARSE	300	320
DRILLERS REMARKS:	SAND & GUMBO STREAKS	320	340
	HARD SHALE	340	360
	SAND	360	380
	CORDED LENS	380	400
	MED. HARD SHALE	400	420
	MED. HARD SHALE	420	440
	MED. HARD SHALE	440	460
	MED. HARD SHALE	460	480
	HARD SHALE	480	500
	HARD SHALE	500	520
	HARD SHALE	520	540
	HARD SHALE	540	560
	HARD SHALE	560	580
	HARD SHALE	580	600
	HARD SHALE	600	620
	HARD SHALE & SAND	620	640
	SAND	640	660
	SAND	660	680
	SAND	680	700
	HARD SHALE	700	720
	HARD SHALE	720	740
	HARD SHALE	740	760
	HARD SHALE	760	780
	HARD SHALE	780	800


LIPE WELL & SUPPLY CO., INC.

LARRY LIPE, VICE PRESIDENT

MISS. BD. OF WATER COMM.

If well telescopes please sketch and show depths.

GROUND LEVEL

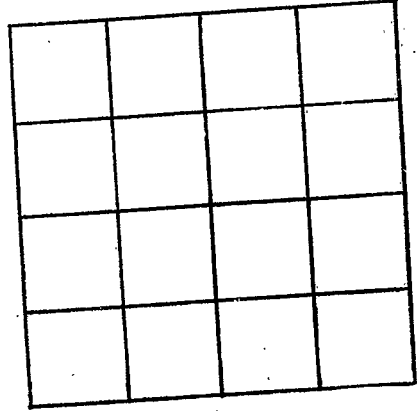

SECTION _____

Please indicate well location X.

ADDITIONAL INFORMATION

A series of horizontal lines for writing additional information, starting below the 'ADDITIONAL INFORMATION' header and extending down to the bottom of the page.

If more than one screen, show locations of each on sketch.