

Big Stream

YALOBUSHA

A 35

10-3-74

MISSISSIPPI
BOARD OF WATER COMMISSIONERS
416 North State Street
Jackson, Mississippi 39201

CODED

WATER WELL DRILLERS LOG

Oct 3 1974 J B Cain Yalobusha
date well completed firm name county well located

LANDOWNER: George Nelson

description of formations encountered from to

Blue Clay 0 250

(mailing address)

Sand 250 280

WELL LOCATION:

sec 34 T 26 N R 6 E 15F
6 miles N-E of Okland
(distance) (direction) (nearest town)

WELL PURPOSE: Home
(home, irrigation, municipal, industrial)

CODED

WELL COMPLETION DATA:

- (1) diameter (inches) 4"
- (2) total depth (feet) ~~280~~ 280
- (3) static water level (feet) 100 below top of ground.
- (4) casing Plast. 0280
(material) (depth)
- (size) if telescope see back.
- (5) screen 10' 280
(length) (depth to top)
4" Plastic
(size) (material)
- (6) pump 7.4 10
(HP) (yield gpm)
Elec
(type power)
- (7) electric log (yes or no)

(organization running log)

(8) how well bottom plugged Plug

DRILLERS REMARKS:


RECEIVED 1510
DEC 10 1974

JAN 13 1975

MISS. BD. OF WATER COM.

If well telescopes please sketch and show depths.

GROUND LEVEL

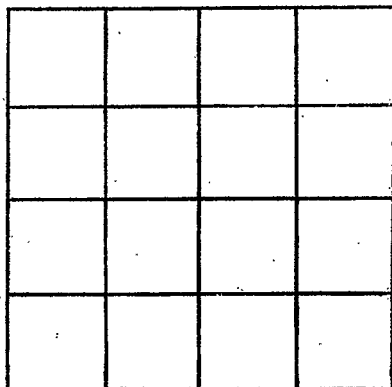

SECTION _____

Please indicate well location X.

ADDITIONAL INFORMATION

If more than one screen, show locations of each on sketch.