

YALOBUSHA
A 36
1-25-75

MISSISSIPPI
BOARD OF WATER COMMISSIONERS CODED
416 North State Street
Jackson, Mississippi 39201

WATER WELL DRILLERS LOG

Jan 25 1975 Nelson Cain Yalobusha
date well completed firm name county well located


LANDOWNER James Williams Oakland	description of formations encountered	from	to
(mailing address)	Blue Clay Sand / Strata	0	110
WELL LOCATION: IIS sec. 29 T 3 S R 6 E 5 miles N-E of Oakland (distance) (direction) (nearest town)	Sand	105	120
WELL PURPOSE: Home (home, irrigation, municipal, industrial)	CODED		
WELL COMPLETION DATA:			
(1) diameter (inches) 4"			
(2) total depth (feet) 120			
(3) static water level (feet) 100 below top of ground.			
(4) casing Plastic 120 (material) (depth)			
(size) If telescope see back.			
(5) screen 10' 110 (length) (depth to top)			
4" Plastic (size) (material)			
(6) pump 1/2 12 (HP) (yield gpm)			
Elic (type power)			
(7) electric log No (yes or no)			
(organization running log)			
(8) how well bottom plugged Wash Bed			
DRILLERS REMARKS:			

MAR 31 1975

MISS. BD. OF WATER COMMISSIONERS

If well telescopes please sketch and show depths.

GROUND LEVEL

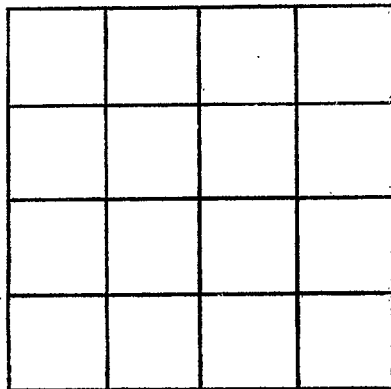

SECTION _____

Please indicate well location X.

ADDITIONAL INFORMATION

If more than one screen, show locations of each on sketch.