

Zalobusha  
A 2001  
3-25-76

MISSISSIPPI  
 BOARD OF WATER COMMISSIONERS  
 416 North State Street  
 Jackson, Mississippi 39201

WATER WELL DRILLERS LOG

3-25 1976 Life Well Co. Zalobusha  
 date well completed firm name county well located

LANDOWNER:  
Robert McMillen  
Batesville MS,  
 (mailing address)

description of formations encountered	from	to
TOP SOIL	0	20
red sand	20	40
" "	40	60
" "	60	80
coarse sand	80	100
clay	100	120
" "	120	140
sand and clay	140	160

WELL LOCATION:  
 sec. 3 T 26 N R 7 E  
4 miles south of PORE  
 (distance) (direction) (nearest town)

WELL PURPOSE:  
 (home, irrigation, municipal, industrial)

WELL COMPLETION DATA:

(1) diameter (inches) 4

(2) total depth (feet) 154

(3) static water level (feet) 70 below above top of ground.

(4) casing PVC 144  
 (material) (depth)  
4 If telescope see back.  
 (size)


(5) screen 10 144  
 (length) (depth to top)  
4 PVC  
 (size) (material)

(6) pump 3/4 10  
 (HP) (yield gpm)  
elec  
 (type power)

(7) electric log no  
 (yes or no)  
no  
 (organization running log)

(8) how well bottom plugged PVC


DRILLERS REMARKS: COP

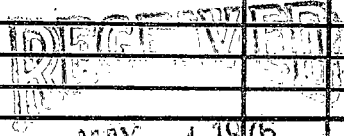

MAY - 1 1976

If well telescopes please sketch and show depths.

GROUND LEVEL

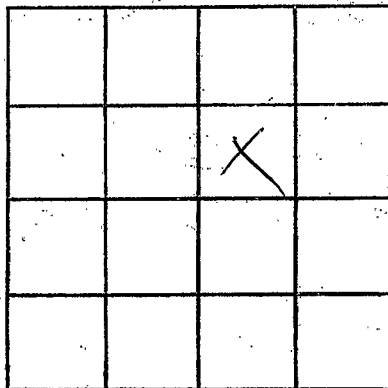

SECTION 3

Please indicate well location X.

ADDITIONAL INFORMATION

If more than one screen,  
show locations of each on sketch.