

YALOBUSHA
A 2003
7-22-78

**MISSISSIPPI
BOARD OF WATER COMMISSIONERS**
416 North State Street
Jackson, Mississippi 39201
WATER WELL DRILLERS LOG

7-22-78 date well completed 19 78, Lipe well co. firm name Yalobusha county well located

LANDOWNER:
W. K. Crowell
Oakland Ms.
(mailing address)

description of formations encountered	from	to
top soil	0	20
sand and gravel	20	60
sand	60	78

WELL LOCATION:
sec. 30 T 26 N R 46 E
2 miles north of oakland
(distance) (direction) (nearest town)

WELL PURPOSE: none
(home, irrigation, municipal, industrial)

WELL COMPLETION DATA:

(1) diameter (inches) 4

(2) total depth (feet) 78

(3) static water level (feet) 15 below top of ground.

(4) casing pvc, 74 (material) (depth)
4 (size) if telescope see back.

(5) screen 4, 74 (length) (depth to top)
4 (size) pvc (material)

(6) pump 3/4, 10 (HP) (yield gpm)
elec. (type power)

(7) electric log no (yes or no)
no (organization running log)

(8) how well bottom plugged pvc cap


RECEIVED
SEP 12 1978

DRILLERS REMARKS:

MISS. BD. OF WATER COMMISSIONERS

If well telescopes please sketch and show depths.

GROUND LEVEL

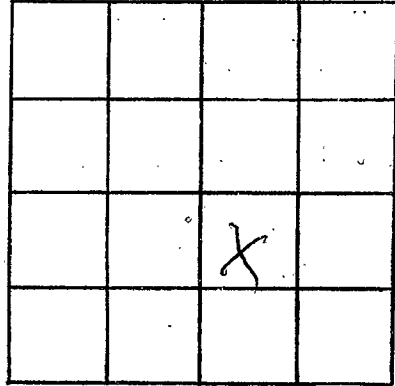

SECTION 30

Please indicate well location X.

ADDITIONAL INFORMATION

Lined area for additional information.

If more than one screen, show locations of each on sketch.