

Yalobusha
A 2000

MISSISSIPPI
 BOARD OF WATER COMMISSIONERS
 416 North State Street
 Jackson, Mississippi 39201

WATER WELL DRILLERS LOG

2-5-82 19 Austin Cain Well Service Yalobusha
 date well completed firm name county well located

LANDOWNER: Mary Hall
Lake Estate
Oakland Ms Hwy 32 E
 (mailing address)

WELL LOCATION:
 sec. 28 T 26 N ✓ R 6 E
 S W
5 miles E of Oakland
 (distance) (direction) (nearest town)

WELL PURPOSE: Home
 (home, irrigation, municipal, industrial)

WELL COMPLETION DATA:

(1) diameter (inches) 4

(2) total depth (feet) 160

(3) static water level (feet) 80 below above
 top of ground.

(4) casing Pvc 160
 (material) (depth)

(size) if telescope see back.

(5) screen 10' 160
 (length) (depth to top)

4" Pvc
 (size) (material)

(6) pump 3/4 10
 (HP) (yield gpm)

Eject
 (type power)

(7) electric log _____
 (yes or no)

_____ (organization running log)

(8) how well bottom plugged Wash Bottom

description of formations encountered	from	to
<u>Clay</u>	<u>0</u>	<u>15</u>
<u>Sand & Clay</u>	<u>15</u>	<u>65</u>
<u>Blue Clay</u>	<u>65</u>	<u>70</u>
<u>Rock</u>	<u>70</u>	<u>71</u>
<u>Blue Clay</u>	<u>71</u>	<u>95</u>
<u>Rock</u>	<u>95</u>	<u>95 1/2</u>
<u>Blue Clay</u>	<u>95 1/2</u>	<u>138</u>
<u>Sand</u>	<u>138</u>	<u>160</u>

DRILLERS REMARKS:


DEPT. OF NATURAL RESOURCES
 BUREAU OF LAND & WATER RESOURCES

MAR - 8 1982

RECEIVED

If well telescopes please sketch and show depths.

GROUND LEVEL

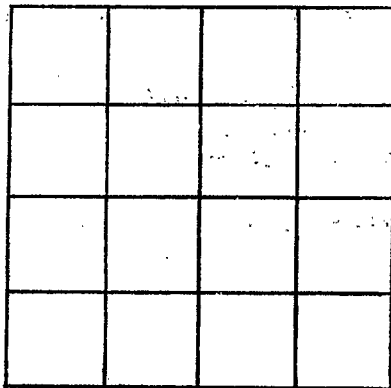

SECTION _____

Please indicate well location X.

ADDITIONAL INFORMATION

If more than one screen, show locations of each on sketch.