

Yalobusha  
A. 2007

MISSISSIPPI  
 BOARD OF WATER COMMISSIONERS  
 416 North State Street  
 Jackson, Mississippi 39201

WATER WELL DRILLERS LOG

2-13-82 19 Austin Coin Well Service Yalobusha  
 date well completed firm name County well located

LANDOWNER Mr Herman Harth  
Lake Estate  
Oakland Ms Hwy 32 E  
 (mailing address)

WELL LOCATION:  
 sec 28 T 26 N 6 E  
 S W  
5 miles E of Oakland  
 (distance) (direction) (nearest town)

WELL PURPOSE: Home  
 (home, irrigation, municipal, industrial)

WELL COMPLETION DATA:

(1) diameter (inches) 4"

(2) total depth (feet) 165

(3) static water level (feet) 80 below  
 top of ground. above

(4) casing Pvc 165  
 (material) (depth)

(size) If telescope see back.

(5) screen 10' 155  
 (length) (depth to top)

4" Pvc  
 (size) (material)

(6) pump 3/4 10  
 (HP) (yield gpm)

Elect  
 (type power)

(7) electric log \_\_\_\_\_  
 (yes or no)

\_\_\_\_\_  
 (organization running log)

(8) how well bottom plugged Wash Bottom

description of fomations encountered	from	to
	<u>Clay</u>	<u>0</u>
<u>SAND &amp; Clay</u>	<u>15</u>	<u>60</u>
<u>Blue Clay</u>	<u>60</u>	<u>80</u>
<u>Rock</u>	<u>80</u>	<u>80 1/2</u>
<u>Blue Clay</u>	<u>80 1/2</u>	<u>118</u>
<u>Blue Clay</u>	<u>118</u>	<u>135</u>
<u>SAND</u>	<u>135</u>	<u>160</u>

DRILLERS REMARKS:


DEPT. OF NATURAL RESOURCES  
 BUREAU OF LAND & WATER RESOURCES

MAR - 8 1982

RECEIVED

If well telescopes please sketch and show depths.

GROUND LEVEL

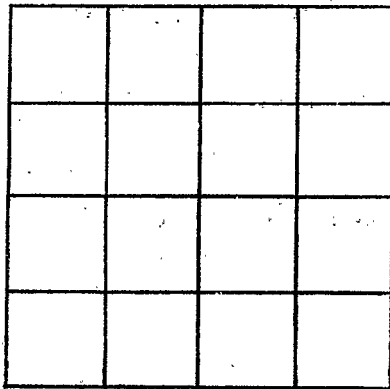

SECTION \_\_\_\_\_

Please indicate well location X.

ADDITIONAL INFORMATION

If more than one screen,  
show locations of each on sketch.