

Yalobusha
A 2008

MISSISSIPPI
 BOARD OF WATER COMMISSIONERS
 416 North State Street
 Jackson, Mississippi 39201

WATER WELL DRILLERS LOG

Lynn Wells Supply Yalobusha
 firm name county well located

9-13-82 19
 date well completed

LANDOWNER:
Garrett Crain
Water Valley, MS.
 (mailing address)

WELL LOCATION:
 sec. 27 T. 26 N. R. 6 E
 S W
 (distance) miles (direction) of (nearest town)

WELL PURPOSE:
 (home, irrigation, municipal, industrial)

WELL COMPLETION DATA:

- (1) diameter (inches) 4
- (2) total depth (feet) 118
- (3) static water level (feet) 70 below above top of ground.
- (4) casing PVC, 110,
 (material) (depth)
4 if telescope see back.
 (size)
- (5) screen 3, 110
 (length) (depth to top)
4, PVC
 (size) (material)
- (6) pump 1/2, 9
 (HP) (yield gpm)
 (type power)
- (7) electric log No
 (yes or no)
 (organization running log)
- (8) how well bottom plugged PVC
cap

description of formations encountered	from:	to:
<u>Top soil</u>	<u>0</u>	<u>20</u>
<u>Yellow Clay</u>	<u>20</u>	<u>30</u>
<u>Block Clay</u>	<u>30</u>	<u>40</u>
<u>" "</u>	<u>40</u>	<u>60</u>
<u>" "</u>	<u>60</u>	<u>80</u>
<u>" "</u>	<u>80</u>	<u>100</u>
<u>Sand</u>	<u>100</u>	<u>118</u>

DEPT. OF NATURAL RESOURCES
 BUREAU OF LAND & WATER RESOURCES


FEB - 2 1983

RECEIVED

DRILLERS REMARKS:

If well telescopes please sketch and show depths.

GROUND LEVEL

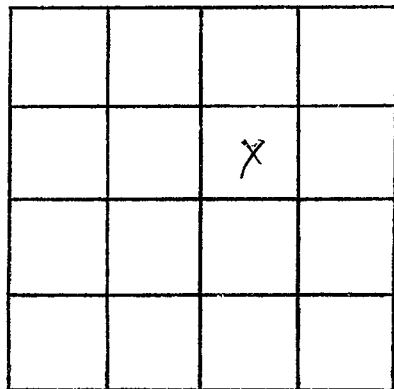

SECTION _____

Please indicate well location X.

ADDITIONAL INFORMATION

If more than one screen,
show locations of each on sketch.