

Yalobusha
A 2000

MISSISSIPPI
 BOARD OF WATER COMMISSIONERS
 416 North State Street
 Jackson, Mississippi 39201

WATER WELL DRILLERS LOG

Apr 19 *82* *Spennell Supply* *Yalobusha*
 date well completed firm name county well located

LANDOWNER:
Kirby Elliott
Grenda Miss
 (mailing address)

WELL LOCATION:
 sec *27* T *26* N S R *6* E W
 (distance) miles (direction) of (nearest town)

WELL PURPOSE:
 (home, irrigation, municipal, industrial)

WELL COMPLETION DATA:

(1) diameter (inches) *4*

(2) total depth (feet) *150*

(3) static water level (feet) *110* below above top of ground.

(4) casing *PVC*, *148*,
 (material) (depth)
 (size) if telescope see back.

(5) screen *8'*, *148*
 (length) (depth to top)
4, *PVC*
 (size) (material)

(6) pump *3/4*, *10*
 (HP) (yield gpm)
 (type power)

(7) electric log *no*
 (yes or no)
 (organization running log)

(8) how well bottom plugged *PVC*
cap

| description of formations encountered | from to | |
|---------------------------------------|------------|------------|
| | | |
| <i>Top soil</i> | <i>0</i> | <i>15</i> |
| <i>blue clay</i> | <i>15</i> | <i>20</i> |
| <i>" "</i> | <i>20</i> | <i>40</i> |
| <i>" "</i> | <i>40</i> | <i>60</i> |
| <i>" "</i> | <i>60</i> | <i>80</i> |
| <i>" "</i> | <i>80</i> | <i>100</i> |
| <i>" "</i> | <i>100</i> | <i>120</i> |
| <i>clays sand</i> | <i>120</i> | <i>140</i> |
| <i>sand</i> | <i>140</i> | <i>150</i> |

DEPT. OF NATURAL RESOURCES
 BUREAU OF LAND & WATER RESOURCES

FEB - 2 1983


RECEIVED

DRILLERS REMARKS:

KIRBY Elliott

If well telescopes please sketch and show depths.

GROUND LEVEL

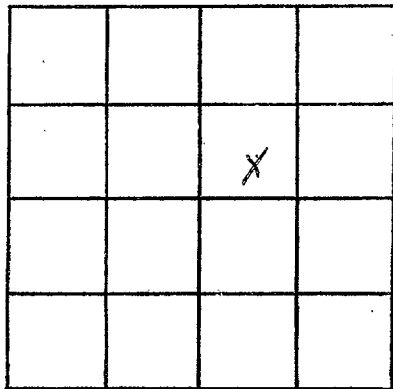

SECTION _____

Please indicate well location X.

ADDITIONAL INFORMATION

If more than one screen,
show locations of each on sketch.