

MISSISSIPPI DEPARTMENT OF NATURAL RESOURCES

Bureau of Land and Water Resources

Southport Mall

P.O. Box 10631

Jackson, Mississippi 39209

WATER WELL DRILLERS LOG

Yalobusha  
Asou


date well completed 4-15 1991 firm name LIFE WELL & SUPPLY CO., INC. county well located Yalobusha

LANDOWNER: <u>JIMMY SANDERS</u>		description of formations encountered	from	to
<u>2064 King Rd.</u>				
<u>Southaven, Ms. 38671</u> (mailing address)		<u>clay, SAND, pea gravel</u>	<u>20</u>	<u>40</u>
WELL LOCATION:		<u>pea gravel, to larger gravel</u>	<u>40</u>	<u>60</u>
sec. <u>29</u> T <u>26</u> N R <u>7</u> E		<u>GRAVEL, clay mixed with sand at bottom</u>	<u>60</u>	<u>80</u>
<u>2</u> miles <u>N</u> of <u>Oxford</u>		<u>clay-sand mixed back to gravel</u>	<u>80</u>	<u>100</u>
(distance) (direction) (nearest town)		<u>Gravel, soft clay with a little sand</u>	<u>100</u>	<u>120</u>
WELL PURPOSE: (home, irrigation, municipal, industrial)		<u>Sand about 136' then rock</u>	<u>120</u>	<u>140</u>
WELL COMPLETION DATA:				
(1) diameter (inches) <u>4"</u>				
(2) total depth (feet) <u>136</u>				
(3) static water level (feet) _____ below / above top of ground.				
(4) casing <u>PVC</u> , <u>126</u> (material) (depth)				
<u>4</u> if telescope see back. (size)				
(5) screen <u>10</u> , <u>126</u> (length) (depth to top)				
<u>4</u> , <u>PVC</u> (size) (material)				
(6) pump <u>3/4</u> (HP) (yield gpm)				
_____ (type power)				
(7) electric log <u>no</u> (yes or no)				
_____ (organization running log)				
(8) how well bottom plugged <u>Capped</u>				
DRILLERS REMARKS:				

RECEIVED  
JUN 28 1991  
Dent of Environmental Quality  
Bureau of Land & Water Resources

If well telescopes please sketch and show depths.

GROUND LEVEL

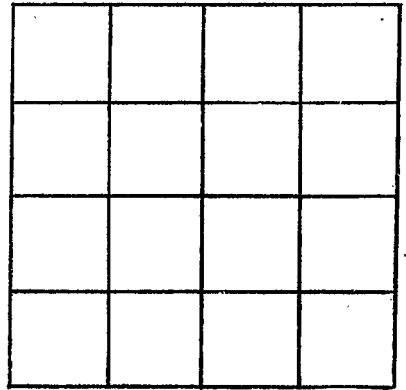

SECTION \_\_\_\_\_

Please indicate well location X.

ADDITIONAL INFORMATION

If more than one screen,  
show locations of each on sketch.