

MISSISSIPPI DEPARTMENT OF NATURAL RESOURCES

Bureau of Land and Water Resources

Southport Mall

P.O. Box 10631

Jackson, Mississippi 39209

WATER WELL DRILLERS LOG

Yalobusha
A 200

6-4-91 19
date well completed

Lipe Well & Supply
firm name

Yalobusha
county well located

LANDOWNER: Sheila Gray
May 01
Dakland, Ms 38948
(mailing address)


WELL LOCATION:
sec. 18 T. 26(N) R. 7 E
3 miles N of Dakland
(distance) (direction) (nearest town)

WELL PURPOSE:
(home, irrigation, municipal, industrial)

WELL COMPLETION DATA:

- (1) diameter (inches) 4"
- (2) total depth (feet) 162'
- (3) static water level (feet) _____ below
top of ground. above
- (4) casing PVC 154'
(material) (depth)
4 If telescope see back.
(size)
- (5) screen 10 152'
(length) (depth to top)
(size) (material)
- (6) pump 3/4 12
(HP) (yield gpm)
Delta
(type power)
- (7) electric log (yes or no)
(organization running log)
- (8) how well bottom plugged _____

description of formations encountered	from to	
top soil, clay	0	20
clay	20	40
clay, sand, small gravel	40	60
small gravel	60	80
small gravel, sand w/clay	80	100
little sand mixed w/ gravel	100	120
little sand at first part gravel	120	140
gravel, fine gravel, clay about 15' gravel	140	160
gravel, then rock about 167'	160	170

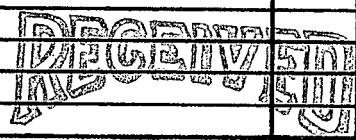


JUN 28 1991

Dept. of Environmental Quality
Bureau of Land & Water Resources

DRILLERS REMARKS:

If well telescopes please sketch and show depths.

GROUND LEVEL

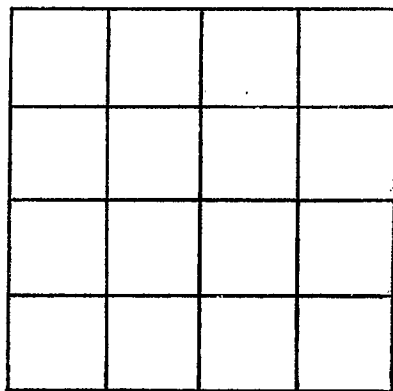

SECTION _____

Please indicate well location X.

ADDITIONAL INFORMATION

If more than one screen, show locations of each on sketch.