

ALCO BUSH
A 2013

MISSISSIPPI
 BOARD OF WATER COMMISSIONERS
 416 North State Street
 Jackson, Mississippi 39201

WATER WELL DRILLERS LOG

4-15-92 19 Lupe Well Supply Yalobusha
 date well completed firm name county well located

LANDOWNER: Dorothy Eason
Box 51
Oakland MS
 (mailing address)

WELL LOCATION:
 sec 36 T 26N R 17E S 1
2 miles N of Oakland
 (distance) (direction) (nearest town)

WELL PURPOSE:
 (home, irrigation, municipal, industrial)

- WELL COMPLETION DATA:
- (1) diameter (inches) 4"
 - (2) total depth (feet) 125
 - (3) static water level (feet) 95 below above top of ground.
 - (4) casing PVC, 115,
 (material) (depth)
4" if telescope see back.
 (size)
 - (5) screen 10', 115
 (length) (depth to top)
4", PVC
 (size) (material)
 - (6) pump 3/4, 10
 (HP) (yield gpm)
elec.
 (type power)
 - (7) electric log no
 (yes or no)
 (organization running log)
 - (8) how well bottom plugged cap

description of formations encountered	from	to
<u>top soil clay</u>	<u>0</u>	<u>20</u>
<u>clay then sand</u>	<u>20</u>	<u>40</u>
<u>sand w/ thin clay gravel</u>	<u>40</u>	<u>60</u>
<u>sand and gravel</u>	<u>60</u>	<u>80</u>
<u>sand & little pea gravel</u>	<u>80</u>	<u>100</u>
<u>sand coarse</u>	<u>100</u>	<u>120</u>
<u>sand coarse then soft clay</u>	<u>120</u>	<u>129</u>


RECEIVED
 MAY 07 1992

Dept. of Environmental Quality
 Bureau of Land & Water Resources

DRILLERS REMARKS:

If well telescopes, please sketch and show depths.

GROUND LEVEL

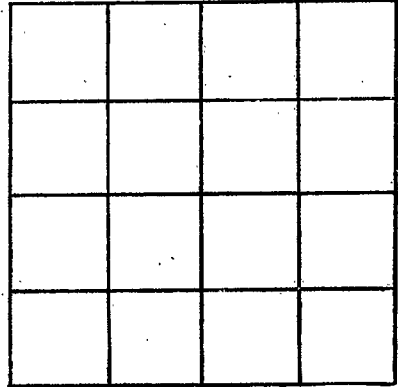

SECTION _____

Please indicate well location X.

ADDITIONAL INFORMATION

If more than one screen, show locations of each on sketch.