

Yalobusha
A 2014

MISSISSIPPI
 BOARD OF WATER COMMISSIONERS
 416 North State Street
 Jackson, Mississippi 39201

WATER WELL DRILLERS LOG

4-15-92

19

Lipe Well Supply

firm name

Yalobusha

county well located

LANDOWNER: Helen Elson

Hwy 51

Oakland, Ms

(mailing address)

WELL LOCATION:

sec. 36 T. 20 N.



2 miles N

(distance) (direction)

of Oakland

(nearest town)

WELL PURPOSE: home

(home, irrigation, municipal, industrial)

WELL COMPLETION DATA:


- (1) diameter (inches) 4"
- (2) total depth (feet) 126
- (3) static water level (feet) 95 below above top of ground.
- (4) casing PVC, 116,
 (material) (depth)
4" if telescope see back.
 (size)
- (5) screen 10, 116
 (length) (depth to top)
4" PVC
 (size) (material)
- (6) pump 3/4, 10
 (HP) (yield gpm)
elec
 (type power)
- (7) electric log no
 (yes or no)
K
 (organization running log)
- (8) how well bottom plugged clay

description of formations encountered

from

to

<u>top soil</u>	<u>0</u>	<u>10</u>
<u>sand</u>	<u>10</u>	<u>20</u>
<u>sand clay</u>	<u>20</u>	<u>40</u>
<u>sand red gravel</u>	<u>40</u>	<u>60</u>
<u>sand pea gravel</u>	<u>60</u>	<u>80</u>
<u>sand</u>	<u>80</u>	<u>100</u>
<u>sand</u>	<u>100</u>	<u>120</u>

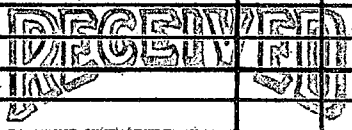


MAY 07 1992

Dept. of Environmental Quality
 Bureau of Land & Water Resources

DRILLERS REMARKS:

If well telescopes please sketch and show depths.

GROUND LEVEL

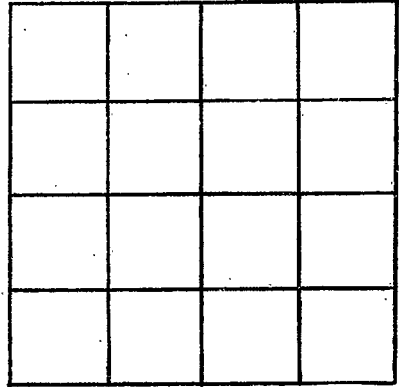

SECTION _____

Please indicate well location X.

ADDITIONAL INFORMATION

If more than one screen, show locations of each on sketch.