

Yalobusha
B3
3-22-69

MISSISSIPPI
BOARD OF WATER COMMISSIONERS
416 North State Street
Jackson, Mississippi 39201

CODED

WATER WELL DRILLERS LOG

3-22-1969 date well completed
SARTAN Well Supp firm name
Yalobusha county well located

SWEARENGEN

LANDOWNER: ~~SWEARENGEN~~
Thomas

description of fomations encountered	from	to
Buck shot	1'	20'
Red Cl. 114 S2nd	20'	23'
C. 124	23'	26'
Quartz S2nd	26'	47'
Water S2nd	47'	52'
Stopped on Black C124		

(mailing address)

WELL LOCATION:
sec. 9 T. 26(N) S. R. 5 E. W.V.M.
9 miles W of (distance) (direction) (nearest town)

WELL PURPOSE: Store & Home
(home, irrigation, municipal, industrial)

WELL COMPLETION DATA:

(1) diameter (inches) 2"

(2) total depth (feet) 52'

(3) static water level (feet) 23' below above top of ground.

(4) casing Steel, 48' (material) (depth)
If telescope see back.
(size)

(5) screen 4' 4' (length) (depth to top)
1 1/4" SS slot (size) (material)

(6) pump 1 65 (HP) (yield gpm)
Elect (type power)

(7) electric log NO (yes or no)

(organization running log)

CODED

(8) how well bottom plugged
Drive Point


DRILLERS REMARKS:

APR - 9 1969

MISS. RD. OF
WATER COMM.

If well telescopes please sketch and show depths.

GROUND LEVEL

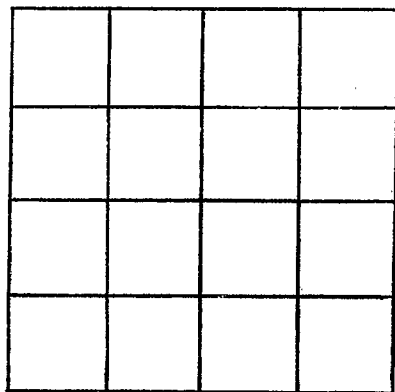

SECTION 9

Please indicate well location X.

ADDITIONAL INFORMATION

If more than one screen, show locations of each on sketch.