

YALOBUSHA
B 6
4-68

MISSISSIPPI
 BOARD OF WATER COMMISSIONERS
 416 North State Street
 Jackson, Mississippi 39201

CODED

WATER WELL DRILLERS LOG

4. 5 19 68 James R. Lipe Yalobuscha
 date well completed firm name county well located

LANDOWNER: Wayne Williamson
Water Valley
Miss.
 (mailing address)

description of formations encountered	from	to
TOP SOIL	0	20
Sand	20	40
Sand	40	60
Black clay	60	80
" "	80	100
water sand	100	124


WELL LOCATION:
 sec. 17 T 26 N S R 5 W E
10 miles W of Water Valley
 (distance) (direction) (nearest town)

WELL PURPOSE:
 (home, irrigation, municipal, industrial)

WELL COMPLETION DATA:


- (1) diameter (inches) 4"
- (2) total depth (feet) 124'
- (3) static water level (feet) 50 below above
 top of ground.
- (4) casing Plastic 114
 (material) (depth)
 (size) If telescope see back.
- (5) screen 10' 114
 (length) (depth to top)
4 Plastic
 (size) (material)
- (6) pump 3/4 10
 (HP) (yield gpm)
Elec.
 (type power)
- (7) electric log No
 (yes or no)
 (organization running log)
- (8) how well bottom plugged Plastic
plug 4"

DRILLERS REMARKS:

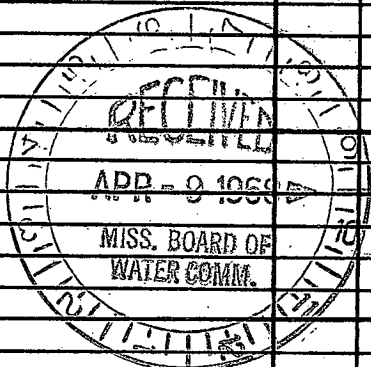

If well telescopes please sketch and show depths.

GROUND LEVEL

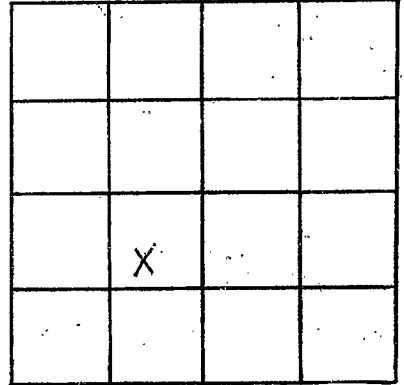

SECTION 17

Please indicate well location X.

ADDITIONAL INFORMATION

If more than one screen,
show locations of each on sketch.