

Yalobusha  
B 7  
7-1-69

MISSISSIPPI  
 BOARD OF WATER COMMISSIONERS  
 416 North State Street  
 Jackson, Mississippi 39201

CODED

WATER WELL DRILLERS LOG

7-1 1969 SARTAIN Well Supply 7/2/obusha  
 date well completed firm name county well located

LANDOWNER: Dale Wilbourn

description of formations encountered from to

AIRPORT Rd.

Water Valley, Miss  
 (mailing address)

Red clay 1' 20'

WELL LOCATION:

sec 25 T. 10 N R. 5 E  
25 3 miles NW of Water Valley  
 (distance) (direction) (nearest town)

DRY Sand 20' 82'  
Red clay 82' 83'

WELL PURPOSE: Home  
 (home, irrigation, municipal, industrial)

WELL COMPLETION DATA:

- (1) diameter (inches) 2"
- (2) total depth (feet) 107'
- (3) static water level (feet) 100 below above top of ground.
- (4) casing Steel, 102',  
 (material) (depth)

White Fine 83' 96'

Sand  
Pink clay 96' 97'

(size) If telescope see back.

- (5) screen 5', 102'  
 (length) (depth to top)  
1 1/4", S.S. GAUZE  
 (size) (material)

- (6) pump 3/4, 4 1/2  
 (HP) (yield gpm)

- (7) electric log Electric  
 (type power)  
NO  
 (yes or no)

(organization running log)


- (8) how well bottom plugged Drive Point

DRILLERS REMARKS: There was  
No water in 1st  
5' of water sand

NO. 1969  
 MISSISSIPPI  
 BOARD OF  
 WATER COMMISSIONERS

If well telescopes please sketch and show depths.

GROUND LEVEL

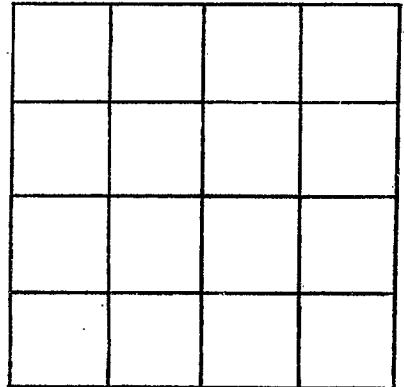

SECTION 25

Please indicate well location X.

ADDITIONAL INFORMATION

Lined area for additional information, consisting of approximately 20 horizontal lines.

If more than one screen, show locations of each on sketch.