

Yalobusha
B8
7-3-69

MISSISSIPPI
 BOARD OF WATER COMMISSIONERS
 416 North State Street
 Jackson, Mississippi 39201

CODED

WATER WELL DRILLERS LOG

July 3 19*69* *Robinson Well Drilling Co* *Yalobusha*
 date well completed firm name county well located

LANDOWNER: *Jimmy Mison*

description of formations encountered

from to

Water Valley, Miss
 (mailing address)

<i>Red Clay + sand</i>	<i>0</i>	<i>20</i>
<i>White Clay + sand</i>	<i>20</i>	<i>30</i>
<i>White Sand</i>	<i>40</i>	<i>55</i>

WELL LOCATION:

sec. *17* T *26* N R *15* E
S *W*
7 miles *SW* of *Water Valley*
 (distance) (direction) (nearest town)

WELL PURPOSE: *home*
 (home, irrigation, municipal, industrial)

WELL COMPLETION DATA:

- (1) diameter (inches) *4"*
- (2) total depth (feet) *55*
- (3) static water level (feet) *27* below above top of ground.
- (4) casing *Plastic, 50*,
 (material) (depth)
4" if telescope see back.
 (size)
- (5) screen *54, 50*
 (length) (depth to top)
4", *gravel packed*
 (size) (material)
- (6) pump *3/4* ~~*1 1/2*~~
 (HP) (yield gpm)
220
 (type power)
- (7) electric log *No*
 (yes or no)
 (organization running log)
- (8) how well bottom plugged *Capped*


OCT 22 1969

DRILLERS REMARKS: *Plastic*
Water Well.

MISS. BD. OF
 WATER COMM.

If well telescopes please
sketch and show depths.

GROUND LEVEL

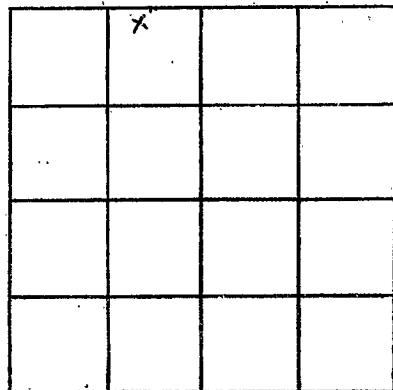

SECTION 17

Please indicate well location X.

ADDITIONAL INFORMATION

If more than one screen,
show locations of each on sketch.