

CODED

MISSISSIPPI
BOARD OF WATER COMMISSIONERS
416 North State Street
Jackson, Mississippi 39201

WATER WELL DRILLERS LOG

Yalobusha Co
B 11
11-69

11-14 date well completed 1969 Sartin Well Supply firm name Yalobusha county well located

LANDOWNER: Cotton Simmons
Airport Rd. W. V. Min
 (mailing address)

description of fomations encountered	from	to
Red clay	1	15
Fine sand	15	42
White clay	42	43
clay & sand	43	68
Blue shale	60	78
Water sand	78	85

WELL LOCATION:
 sec. 36 T. 10 N. R. 5 E
2 1/2 miles W of W. V. M.
 (distance) (direction) (nearest town)

WELL PURPOSE: Home
 (home, irrigation, municipal, industrial)


- WELL COMPLETION DATA: 11
- (1) diameter (inches) 8 1/4
 - (2) total depth (feet) 83 1/2 FT.
 - (3) static water level (feet) 15 below top of ground.
 - (4) casing Steel, 78 (material) (depth)
1 1/4" if telescope see back. (size)
 - (5) screen 5, 5 1/2' (length) (depth to top)
1 1/4", SS GAUZE (size) (material)
 - (6) pump PITCHER Pump (HP) (yield gpm)
 - (type power)
 - (7) electric log (yes or no)
 (organization running log)
 - (8) how well bottom plugged DRIVE WELL

DRILLERS REMARKS:

DEC - 9 1969
 MISS. BO. OF WATER COM.

If well telescopes please sketch and show depths.

GROUND LEVEL

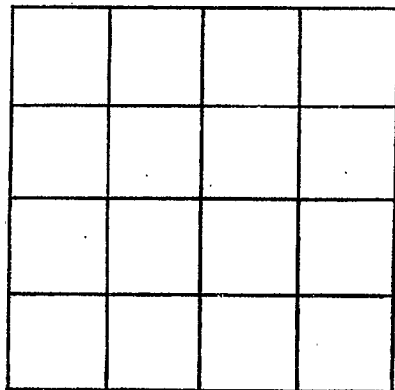

SECTION _____

Please indicate well location X.

ADDITIONAL INFORMATION

If more than one screen, show locations of each on sketch.