

Yalobusha
B12
6-8-72

MISSISSIPPI
 BOARD OF WATER COMMISSIONERS
 416 North State Street
 Jackson, Mississippi 39201

CODED

WATER WELL DRILLERS LOG

June 8 1972 Southwell Drilling Yalobusha
 date well completed firm name county well located

LANDOWNER:
Franklin Bonson
Rt. 2, W. Va. Hwy, Miss
 (mailing address)

description of formations encountered	from	to
<u>11' 3"</u>	<u>1</u>	<u>10</u>
<u>10'</u>	<u>10</u>	<u>19</u>
<u>24'</u>	<u>24</u>	<u>27</u>
<u>20'</u>	<u>20</u>	<u>29</u>
<u>27'</u>	<u>27</u>	<u>27</u>

WELL LOCATION:
 sec. 17 T. 2 S. R. 5 E.
7 miles W of W. Va.
 (distance) (direction) (nearest town)

WELL PURPOSE:
 (home, irrigation, municipal, industrial)

- WELL COMPLETION DATA:
- (1) diameter (inches) 2"
 - (2) total depth (feet) 27'
 - (3) static water level (feet) 23' below/above top of ground.
 - (4) casing Steel, 24' (material) (depth)
2" (size) if telescope see back.
 - (5) screen 5', 24' (length) (depth to top)
1/2", 55, 60, 20 (size) (material)
 - (6) pump 24, 5 (HP) (yield gpm)
Electric (type power)
 - (7) electric log yes or no
organization running log
 - (8) how well bottom plugged

CODED


JUN 15 1972

DRILLERS REMARKS:

WATER

If well telescopes please sketch and show depths.

GROUND LEVEL

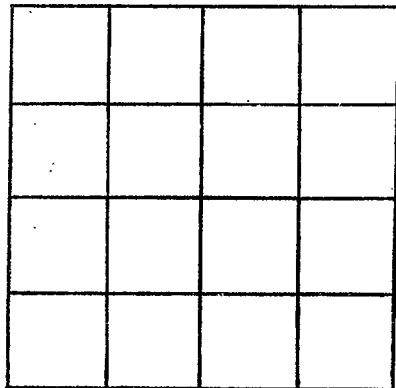

SECTION _____

Please indicate well location X.

ADDITIONAL INFORMATION

If more than one screen, show locations of each on sketch.