

*Yplobusha*  
 6-15  
 6-68

MISSISSIPPI  
 BOARD OF WATER COMMISSIONERS  
 416 North State Street  
 Jackson, Mississippi 39201

CODED  
 CODED

WATER WELL DRILLERS LOG


June 22 1968 *Robinson & Son* *Yplobusha*  
 date well completed firm name county well located

LANDOWNER: <i>A.R. Gammat</i>	description of formations encountered	from	to
<i>Water Valley, Miss</i> (mailing address)	<i>sand &amp; white clay</i> <i>white sand</i>	<i>0</i> <i>40</i>	<i>40</i> <i>70</i>
WELL LOCATION: sec. <i>20</i> T. <i>50</i> N. R. <i>5</i> E <i>5</i> miles (distance) <i>SW</i> (direction) of <i>Water Valley</i> (nearest town)			
WELL PURPOSE: <i>home</i> (home, irrigation, municipal, industrial)			
WELL COMPLETION DATA:			
(1) diameter (inches) <i>2"</i>			
(2) total depth (feet) <i>70</i>			
(3) static water level (feet) <i>20</i> below top of ground.			
(4) casing <i>plastic</i> <i>65</i> (material) (depth)			
<i>2"</i> (size) If telescope see back.			
(5) screen <i>5 ft</i> <i>65</i> (length) (depth to top)			
<i>2"</i> <i>gravel</i> (size) (material)			
(6) pump <i>3/4</i> <i>8</i> (HP) (yield gpm)			
<i>110</i> (type power)			
(7) electric log <i>no</i> (yes or no)			
(organization running log)			
(8) how well bottom plugged <i>cased</i>			
DRILLERS REMARKS: <i>Plastic</i> <i>water well</i>			

JUL 26 1968  
 MISS. BOARD OF  
 WATER COM. M.

If well telescopes please sketch and show depths.

GROUND LEVEL

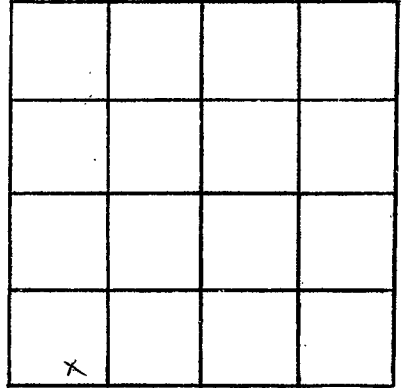

SECTION 20

Please indicate well location X.

ADDITIONAL INFORMATION

If more than one screen,  
show locations of each on sketch.