

CODED

CODED

MISSISSIPPI BOARD OF WATER COMMISSIONERS
416 North State Street
Jackson, Mississippi 39201

WATER WELL DRILLERS LOG

Yalobusha
B 16
2-68

Feb 8 19*68* *Peterson & Son* *Yalobusha*
date well completed firm name county well located

LANDOWNER: *Frank Mathis*
FM

description of formations encountered	from	to
<i>Red sand & Clay</i>	<i>0</i>	<i>40</i>
<i>Blue Clay</i>	<i>40</i>	<i>160</i>
<i>Sand & Clay</i>	<i>160</i>	<i>180</i>
<i>White sand</i>	<i>180</i>	<i>200</i>

Water Valley, Miss
(mailing address)

WELL LOCATION:
15 sec *T 11* N R *5* E
4 1/2 miles *SW* of *Water Valley*
(distance) (direction) (nearest town)


WELL PURPOSE: *Home*
(home, irrigation, municipal, industrial)

WELL COMPLETION DATA:

- (1) diameter (inches) *3 1/2"*
- (2) total depth (feet) *200*
- (3) static water level (feet) *120* below above top of ground.
- (4) casing *Plastic*, *195*,
(material) (depth)
4"
(size) if telescope see back.
- (5) screen *5 ft*, *196*
(length) (depth to top)
6", *gravel packed*
(size) (material)
- (6) pump *3/4* *14*
(HP) (yield gpm)
220
(type power)
- (7) electric log *no*
(yes or no)

(organization running log)
- (8) how well bottom plugged *plugged*

DRILLERS REMARKS: *Plastic*
Water Well

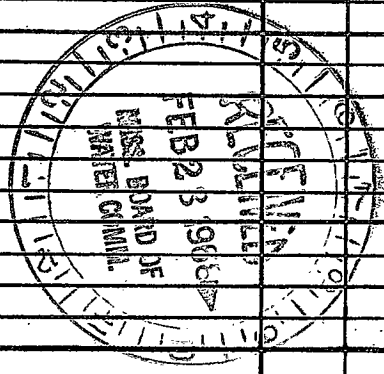

If well telescopes please sketch and show depths.

GROUND LEVEL

		X	

SECTION 14

Please indicate well location X.

ADDITIONAL INFORMATION

If more than one screen,
show locations of each on sketch.