

CODED
CODED

MISSISSIPPI
BOARD OF WATER COMMISSIONERS
416 North State Street
Jackson, Mississippi 39201

WATER WELL DRILLERS LOG

Yalobusha
B I T
7-68


July 15 1968 Robison & Son Yalobusha
date well completed firm name county well located

LANDOWNER: <u>Richard Pater</u>	description of formations encountered	from	to
<u>Water Valley, Miss</u> (mailing address)	<u>Red Clay</u>	<u>0</u>	<u>20</u>
	<u>Sand + Clay</u>	<u>20</u>	<u>60</u>
	<u>blue shale</u>	<u>60</u>	<u>80</u>
	<u>sand</u>	<u>80</u>	<u>90</u>
WELL LOCATION: sec. <u>8</u> T. <u>26</u> N. R. <u>5</u> E <u>6 1/2</u> miles <u>SW</u> of <u>Water Valley</u> (distance) (direction) (nearest town)			
WELL PURPOSE: <u>Home</u> (home, irrigation, municipal, industrial)			
WELL COMPLETION DATA:			
(1) diameter (inches) <u>4"</u>			
(2) total depth (feet) <u>90</u>			
(3) static water level (feet) <u>30</u> below top of ground.			
(4) casing <u>Plastic</u> , <u>85</u> (material) (depth)			
<u>4"</u> (size) if telescope see back.			
(5) screen <u>5 ft</u> , <u>85</u> (length) (depth to top)			
<u>4"</u> , <u>gravel packed</u> (size) (material)			
(6) pump <u>1/2</u> , <u>20</u> (HP) (yield gpm)			
<u>220</u> (type power)			
(7) electric log <u>NO</u> (yes or no)			
(organization running log)			
(8) how well bottom plugged <u>Sealed</u>			
DRILLERS REMARKS: <u>Plastic</u>			
<u>Water Well</u>			

JUL 26 1968
MISS. BOARD OF
WATER COMMISSIONERS

If well telescopes please sketch and show depths.

GROUND LEVEL

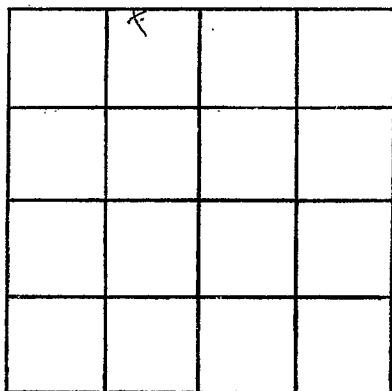

SECTION 8

Please indicate well location X.

ADDITIONAL INFORMATION

If more than one screen,
show locations of each on sketch.