

Yalobusha
B 18
1-67

MISSISSIPPI
 BOARD OF WATER COMMISSIONERS
 416 North State Street
 Jackson, Mississippi 39201


INDEXED
 CODED

WATER WELL DRILLERS LOG

January 10 1967 Roberson + Son Yalobusha
 date well completed firm name county well located


LANDOWNER: <u>E. L. Redwine</u> <u>Rt. 5</u>	description of formations encountered	from	to
<u>Water Valley, Miss</u> (mailing address)			
WELL LOCATION: sec. <u>26</u> T. <u>11</u> N R. <u>5</u> E <u>S</u> <u>W</u>	<u>Clay + Sand</u>	<u>0</u>	<u>20</u>
<u>7</u> miles <u>SW</u> of <u>Water Valley</u> (distance) (direction) (nearest town)	<u>Clay + Sand</u>	<u>20</u>	<u>40</u>
WELL PURPOSE: <u>Home</u> (home, irrigation, municipal, industrial)	<u>Sand</u>	<u>40</u>	<u>60</u>
WELL COMPLETION DATA: (1) diameter (inches) <u>4 in</u>	<u>Sand</u>	<u>60</u>	<u>80</u>
(2) total depth (feet) <u>100 ft</u>	<u>Sand</u>	<u>80</u>	<u>100</u>
(3) static water level (feet) <u>82</u> below above top of ground.			
(4) casing <u>Plastic</u> , <u>95</u> (material) (depth)			
<u>4 in</u> if telescope see back. (size)			
(5) screen <u>5 ft</u> , <u>95</u> (length) (depth to top)			
<u>6 in</u> , <u>Gravel packed</u> (size) (material)			
(6) pump <u>1/2</u> , <u>1.5 gal</u> (HP) (yield gpm)			
<u>T.V.A. 220</u> (type power)			
(7) electric log <u>no</u> (yes or no)			
(organization running log)			
(8) how well bottom plugged <u>Wash</u> <u>bottom</u>			

DRILLERS REMARKS: Plastic
water well

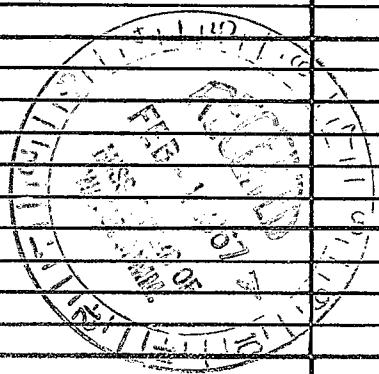

If well telescopes please sketch and show depths.

GROUND LEVEL

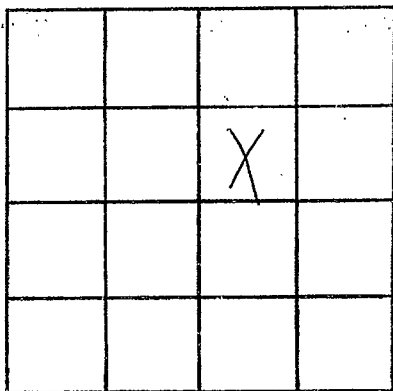

SECTION 26

Please indicate well location X.

ADDITIONAL INFORMATION

If more than one screen,
show locations of each on sketch.