

Yalobusha
B 19
4-67

MISSISSIPPI
BOARD OF WATER COMMISSIONERS
416 North State Street
Jackson, Mississippi 39201
WATER WELL DRILLERS LOG

CODED

CODED

4-16 1967 Lobson & Son Yalobusha
date well completed firm name county well located

LANDOWNER: Mr. J. Durinckall
RT 1
Water Valley, Miss
(mailing address)

description of formations encountered	from	to
<u>Red Clay</u>	<u>0</u>	<u>20</u>
<u>Blue Clay</u>	<u>20</u>	<u>40</u>
<u>Sand & Clay</u>	<u>40</u>	<u>90</u>
<u>White sand</u>	<u>90</u>	<u>100</u>


WELL LOCATION:
sec. 36 T. 10 N R. 5 E
S W
4 miles NW of Water Valley
(distance) (direction) (nearest town)

WELL PURPOSE: Home
(home, irrigation, municipal, industrial)

- WELL COMPLETION DATA:
- (1) diameter (inches) 2 1/2
 - (2) total depth (feet) 100
 - (3) static water level (feet) 45 - below above top of ground.
 - (4) casing Plastic, 95 -
(material) (depth)
2 1/2 if telescope see back.
(size)
 - (5) screen 5 ft, 95 -
(length) (depth to top)
3 1/2, Gravel packed
(size) (material)
 - (6) pump 1 HP 10
(HP) (yield gpm)
EVA 250
(type power)
 - (7) electric log no
(yes or no)

(organization running log)
 - (8) how well bottom plugged Caped

DRILLERS REMARKS: Plastic
Water Well

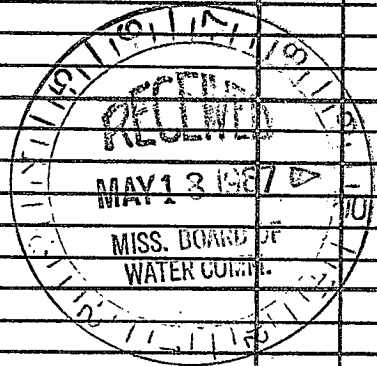

If well telescopes please sketch and show depths.

GROUND LEVEL

		2	

SECTION 26

Please indicate well location X.

ADDITIONAL INFORMATION

If more than one screen,
show locations of each on sketch.