

Yalobusha
B20

8-66

MISSISSIPPI BOARD OF WATER COMMISSIONERS

CODED

CODED

CODED

WATER WELL DRILLERS LOG

Date: Aug. 5, 1966, Driller: Jerry Roberson County Yalobusha
(When well drilled) (Name) (Where well is located)

(1) Owner of Land: Mr. Tutor
(Name)
Rt. 4, Water Valley, Miss.
(Address)

(2) Location: NE 1/4, NW 1/4, Sec. 35 T. 11 R. 5
8 3/4 miles SW of Water Valley
(distance) (direction) (Nearest Town)

(3) Topography: ☒ (Hilly) ☐ (Flat) ☐ (Level)

(4) Purpose of Well: Home
(Domestic Irrigation, Municipal, Industrial, Other)

Information upon completion of well:

(1) Diameter 2 inches.

(2) Total Depth 120 feet.

(3) Water Level 80 feet below top of ground.

(4) Cased to 115, Size 2 in.

(5) Screen: Size 3 in., Length 5 ft.

(6) Were any formations sealed against pollution?

no yes, ☒ no.

If YES depth of formation

Why

Drillers Remarks: Plastic Water Well

Yield in gpm: 6

Size pump: 1 H.P. Jet Pump

Type power: 220-TVA

Description & Color of Materials
Sand, Clay, Red Clay, Shell, etc.

Thick-
ness
Feet

Depth
Feet

Red Clay

20

20

Red sand + Clay

60

80

Blue Clay


10

90

Sand

30

120

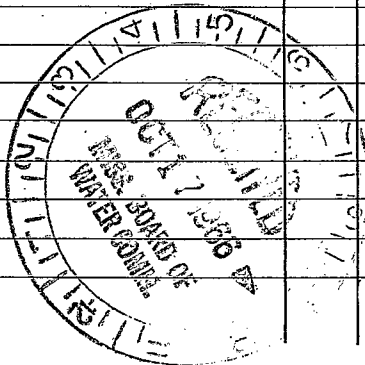

Mail this copy to Board of Water Commissioners 429 Miss. St. Jackson, Miss.

