

0.89 45 03 Long.  
34 07 27 N Lat

Yalobusha  
B23  
3-6-70

MISSISSIPPI  
BOARD OF WATER COMMISSIONERS  
416 North State Street  
Jackson, Mississippi 39201

**CODED**

WATER WELL DRILLERS LOG

MAR. 6 1970 LIPE WELL CO. YALOBUSHA  
date well completed firm name county well located

LANDOWNER:  
WAYNE WILLIAMSON  
WATER VALLEY, MISS  
(mailing address)

WELL LOCATION:  
sec. 17 T. 11 N R. 5 E  
8 miles W of Water Valley  
(distance) (direction) (nearest town)

description of formations encountered	from	to
top soil-sand	0	20
sand	20	40
sand	40	60
sand	60	80
sand	80	100
sand	100	120
sand	120	130

WELL PURPOSE: DOMESTIC  
(home, irrigation, municipal, industrial)

WELL COMPLETION DATA:

(1) diameter (inches) 4"

(2) total depth (feet) 130

(3) static water level (feet) 80' below top of ground.

(4) casing PVC 122' (material) (depth)  
4" (size) if telescope see back.

(5) screen 8' 122' (length) (depth to top)  
4" PVC & SILICA (size) (material)

(6) pump 2 40 (HP) (yield gpm)  
elec (type power)

(7) electric log NO (yes or no)  
✓  
(organization running log)

(8) how well bottom plugged PVC cap

**CODED**


APR 20 1970

MISC. P.  
[Signature]

DRILLERS REMARKS:

If well telescopes please sketch and show depths.

GROUND LEVEL

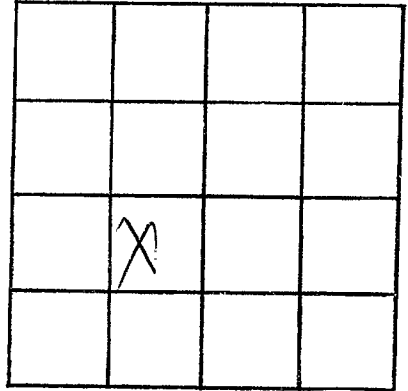

SECTION 17

Please indicate well location X.

ADDITIONAL INFORMATION

If more than one screen,  
show locations of each on sketch.