

Yalobusha
 B 24
 3-9-70

MISSISSIPPI
 BOARD OF WATER COMMISSIONERS
 416 North State Street
 Jackson, Mississippi 39201

CODED

WATER WELL DRILLERS LOG

MAR. 9 1970 LIPE WELL CO. YALOBUSHA
 date well completed firm name county well located

LANDOWNER:
 EDWARD JONES
 WATER VALLEY, MISS
 (mailing address)

description of formations encountered	from	to
sand & clay	0	20
sand	20	40
sand	40	60
sand	60	80
sand	80	104

WELL LOCATION:
 sec. 9 T. 11 N. R. 5 E
 5 miles S of water valley
 (distance) (direction) (nearest town)

WELL PURPOSE: home
 (home, irrigation, municipal, industrial)

WELL COMPLETION DATA:
 (1) diameter (inches) 4"
 (2) total depth (feet) 104
 (3) static water level (feet) 60' below top of ground.
 (4) casing PVC 94' (material) (depth)
 4" (size) if telescope see back.
 (5) screen 10' 94' (length) (depth to top)
 4" PVC + silica (size) (material)
 (6) pump 1/2 10 (HP) (yield gpm)
 elec (type power)
 (7) electric log NO (yes or no)
 (organization running log)
 (8) how well bottom plugged PVC cap

CODED


APR 20 1970

MISS. BD. OF
 WATER COMM.

DRILLERS REMARKS:

If well telescopes please sketch and show depths.

GROUND LEVEL

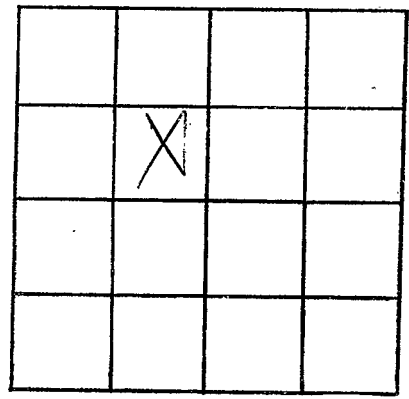

SECTION 9

Please indicate well location X.

ADDITIONAL INFORMATION

Lined area for additional information.

If more than one screen, show locations of each on sketch.