

Yalobusha
B 26
4-20-70

MISSISSIPPI
 BOARD OF WATER COMMISSIONERS
 416 North State Street
 Jackson, Mississippi 39201

WATER WELL DRILLERS LOG

April 20 1970 LIPE WELL CO. YALOBUSHA
 date well completed firm name county well located

LANDOWNER:
Earl Freeman
Waterbally, Miss
 (mailing address)

WELL LOCATION:
 sec 26 T 11 R 5 001
 S E W
6 miles SE of Waterbally
 (distance) (direction) (nearest town)

description of formations encountered	from	to
top soil 2 day	0	20
sand	20	40
sand	40	60
sand	60	80
clay	80	100
sand	100	120
sand	120	140
sand	140	160

WELL PURPOSE: home
 (home, irrigation, municipal, industrial)

WELL COMPLETION DATA:

(1) diameter (inches) 4"

(2) total depth (feet) 164'

(3) static water level (feet) 90' below top of ground.

(4) casing PVC, 156'
 (material) (depth)
4" if telescope see back.
 (size)

(5) screen 8', 156'
 (length) (depth to top)
4", PVC & silica
 (size) (material)

(6) pump 3/4, 11
 (HP) (yield gpm)
elec
 (type power)

(7) electric log no
 (yes or no)
✓
 (organization running log)

(8) how well bottom plugged pvc
plug


MAY 18 1970

MISS. Bd of
 WATER COMM.

DRILLERS REMARKS:

If well telescopes please sketch and show depths.

GROUND LEVEL

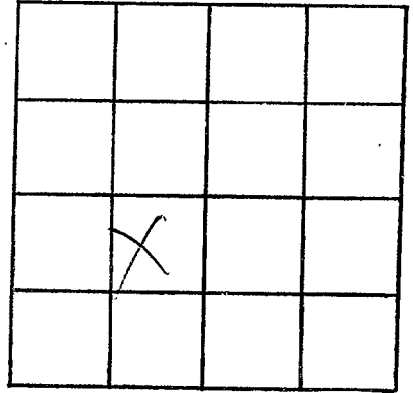

SECTION 26

Please indicate well location X.

ADDITIONAL INFORMATION

If more than one screen,
show locations of each on sketch.