

Yalobusha
B 27
5-11-70

MISSISSIPPI
 BOARD OF WATER COMMISSIONERS
 416 North State Street
 Jackson, Mississippi 39201

WATER WELL DRILLERS LOG

May 11 1970 LIPE WELL CO. YALOBUSHA
 date well completed firm name county well located

LANDOWNER:

W. J. Hayle, Jr.
Water Valley, Miss
 (mailing address)

description of formations encountered

from to

<u>top soil & sand</u>	<u>0</u>	<u>20</u>
<u>sand & clay</u>	<u>20</u>	<u>40</u>
<u>sand</u>	<u>40</u>	<u>60</u>
<u>sand</u>	<u>60</u>	<u>80</u>
<u>sand</u>	<u>80</u>	<u>103</u>

WELL LOCATION:

sec. 17 T. 5 R. 5 001
8 miles W of Water Valley
 (distance) (direction) (nearest town)

WELL PURPOSE: home
 (home, irrigation, municipal, industrial)

WELL COMPLETION DATA:

- diameter (inches) 2"
- total depth (feet) 103
- static water level (feet) 20 below above top of ground.
- casing pvc 98'
 (material) (depth)
2" if telescope see back.
 (size)
- screen 5' 98'
 (length) (depth to top)
2" pvc & silica
 (size) (material)
- pump 1/2 7
 (HP) (yield gpm)
elec
 (type power)
- electric log no
 (yes or no)

(organization running log)

(8) how well bottom plugged pvc cap


MAY 18 1970

MISS. BD. OF
 WATER COMM.

DRILLERS REMARKS:

If well telescopes please sketch and show depths.

GROUND LEVEL

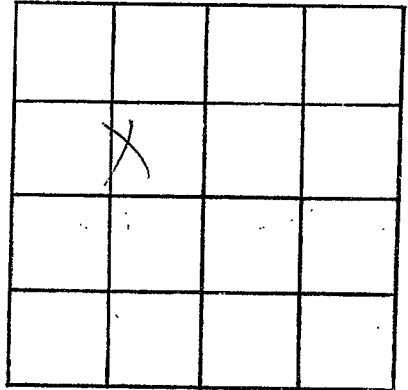

SECTION 17

Please indicate well location X.

ADDITIONAL INFORMATION

Lined area for additional information.

If more than one screen, show locations of each on sketch.