

YALOBUSHA  
B29  
7-22-70

MISSISSIPPI  
 BOARD OF WATER COMMISSIONERS  
 416 North State Street  
 Jackson, Mississippi 39201

**CODED**

WATER WELL DRILLERS LOG

July 22 1970 Lipe Well Co. Yalobussha  
 date well completed firm name county well located

LANDOWNER:  
Layne Moore  
Oakland, Miss  
 (mailing address)

description of formations encountered	from	to
<u>sand</u>	<u>0</u>	<u>20</u>
<u>sand and clay</u>	<u>20</u>	<u>40</u>
<u>sand</u>	<u>40</u>	<u>60</u>
<u>CLAY</u>	<u>60</u>	<u>80</u>
<u>sand</u>	<u>80</u>	<u>100</u>
<u>sand</u>	<u>100</u>	<u>120</u>

WELL LOCATION:  
 sec 23 T 11 R S  
S miles W of Water Well  
 (distance) (direction) (nearest town)

WELL PURPOSE: home  
 (home, irrigation, municipal, industrial)

WELL COMPLETION DATA:

(1) diameter (inches) 4

(2) total depth (feet) 150

(3) static water level (feet) 30 below above top of ground.

(4) casing PVC 95  
 (material) (depth)  
4 if telescope see back.  
 (size)

(5) screen 10 95  
 (length) (depth to top)  
4 PVC  
 (size) (material)

(6) pump 1/2 15  
 (HP) (yield gpm)  
Elec  
 (type power)

(7) electric log no  
 (yes or no)  
no  
 (organization running log)

(8) how well bottom plugged PVC  
PIPS

**CODED**


AUG 24 1970

DRILLERS REMARKS:

MISSISSIPPI BOARD OF WATER COMMISSIONERS

If well telescopes please sketch and show depths.

GROUND LEVEL

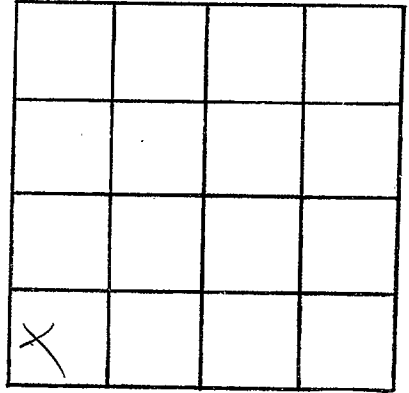

SECTION 25

Please indicate well location X.

ADDITIONAL INFORMATION

Lined area for additional information.

If more than one screen, show locations of each on sketch.