

YALOBUSHA

B30

11-12-70

MISSISSIPPI
 BOARD OF WATER COMMISSIONERS
 416 North State Street
 Jackson, Mississippi 39201

CODED

WATER WELL DRILLERS LOG

Nov. 12 1970
date well completed

SARTAIN Well Sup
firm name

Yalobusha
county well located

LANDOWNER: Banz/d

Cubonka

Rt. 2 Water Valley Miss
(mailing address)

WELL LOCATION:

sec. 34 T. 11 N R. 5 E
 7 miles S-W of W.V. M.
 (distance) (direction) (nearest town)

WELL PURPOSE: Home
(home, irrigation, municipal, industrial)

WELL COMPLETION DATA:

- (1) diameter (inches) 2
- (2) total depth (feet) 131'
- (3) static water level (feet) 90' below above top of ground.
- (4) casing Steel, 126'
(material) (depth)
2" if telescope see back.
(size)
- (5) screen 5', 126'
(length) (depth to top)
1 1/4", SS Gravel
(size) (material)
- (6) pump 7, 42
(HP) (yield gpm)
Electric
(type power)
- (7) electric log NO
(yes or no)

(organization running log)

(8) how well bottom plugged
Drive Point

DRILLERS REMARKS:

description of formations encountered

from to

Red clay	1'	10'
" sand	10	30
sand rock	30	31
Blue clay	31	80
Red sand	80	90
White clay	90	92
" sand	92	112
White clay	112	115
" sand	115	120
" clay	120	121
" sand	121	131


CODED

DEC 10 1970

MISS. Bd. OF WATER COMM.

If well telescopes please sketch and show depths.

GROUND LEVEL

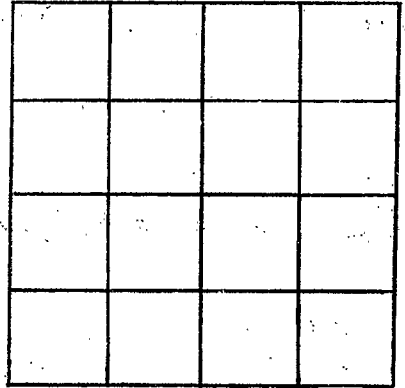

SECTION _____

Please indicate well location X.

ADDITIONAL INFORMATION

If more than one screen, show locations of each on sketch.