

YALOBUSHA  
B 36  
6-5-73

MISSISSIPPI  
 BOARD OF WATER COMMISSIONERS  
 416 North State Street  
 Jackson, Mississippi 39201

**CODED**

WATER WELL DRILLERS LOG

6-5 1973 AMES R. LIPE Yalobusha  
 date well completed firm name county well located

LANDOWNER:	description of formations encountered	from	to
<u>Bailey Walker</u>	<u>red clay</u>	<u>0</u>	<u>20</u>
<u>Water valley Miss,</u> (mailing address)	<u>sand and clay</u>	<u>20</u>	<u>40</u>
	<u>sand</u>	<u>40</u>	<u>60</u>
	<u>"</u>	<u>60</u>	<u>80</u>
	<u>clay</u>	<u>80</u>	<u>100</u>
	<u>"</u>	<u>100</u>	<u>120</u>
	<u>white sand</u>	<u>120</u>	<u>151</u>

WELL LOCATION:  
 sec. 24 T 11 S R 5 E  
5 miles S. W. of Water valley  
 (distance) (direction) (nearest town)

WELL PURPOSE:  
 (home, irrigation, municipal, industrial)

- WELL COMPLETION DATA:
- (1) diameter (inches) 4
  - (2) total depth (feet) 151
  - (3) static water level (feet) 90 below above top of ground.
  - (4) casing PVC 141  
(material) (depth)  
4 if telescope see back.  
(size)
  - (5) screen 10 141  
(length) (depth to top)  
4 PVC  
(size) (material)
  - (6) pump 3/4 10  
(HP) (yield gpm)  
Elec  
(type power)
  - (7) electric log no  
(yes or no)  
no  
(organization running log)
  - (8) how well bottom plugged PVC  
plug


**CODED**

DRILLERS REMARKS:  
 \_\_\_\_\_  
 \_\_\_\_\_  
 \_\_\_\_\_

JUL 5 1973

If well telescopes please sketch and show depths.

GROUND LEVEL

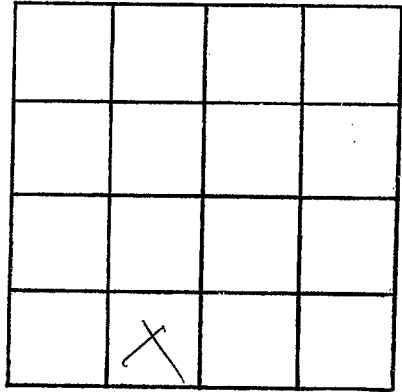

SECTION 24

Please indicate well location X.

ADDITIONAL INFORMATION

A series of horizontal lines for writing additional information, starting below the 'ADDITIONAL INFORMATION' header and extending to the bottom of the page.

If more than one screen, show locations of each on sketch.