

YALOBUSHA

B37

8-1-73

MISSISSIPPI BOARD OF WATER COMMISSIONERS
416 North State Street
Jackson, Mississippi 39201

CODED

WATER WELL DRILLERS LOG

8-1
date well completed

1973 James R. Lipe
firm name

Yalobusha
county well located

LANDOWNER:

Mrs. Willie Duncin

Water valley Miss.
(mailing address)

WELL LOCATION:

sec. 34 T 11 N R 5 E
8 miles West of Watervally
(distance) (direction) (nearest town)

WELL PURPOSE:

(home, Irrigation, municipal, industrial)

WELL COMPLETION DATA:

- (1) diameter (inches) 4
- (2) total depth (feet) 185
- (3) static water level (feet) 100 below top of ground.
- (4) casing PVC, 175' (material), (depth)
4" (size) if telescope see back.
- (5) screen 10', 175' (length), (depth to top)
4" (size), PVC (material)
- (6) pump 3/4 HP, 10 (yield gpm)
elec. (type power)
- (7) electric log no (yes or no)
no (organization running log)
- (8) how well bottom plugged PVC cap

description of fomations encountered

from	to
0	20
20	40
40	60
60	80
80	100
100	120
120	185

Top soil
red clay
red sand
" "
white clay
sand and clay
white sand


CODED

DRILLERS REMARKS:

SEP 6 1973

If well telescopes please sketch and show depths.

GROUND LEVEL

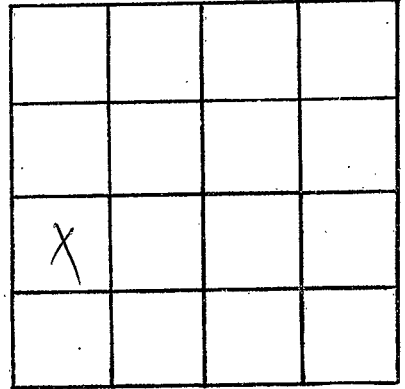

SECTION 34

Please indicate well location X.

ADDITIONAL INFORMATION

If more than one screen, show locations of each on sketch.