

YALOBUSHA
 B 38
 10-31-73

MISSISSIPPI
 BOARD OF WATER COMMISSIONERS
 416 North State Street
 Jackson, Mississippi 39201

CODED

WATER WELL DRILLERS LOG

10-31 date well completed 1973 LIPE well co. firm name yalobusha county well located


| LANDOWNER: | description of formations encountered | from | to |
|--|---------------------------------------|------|-----|
| Charles Orr | Top Soil | 0 | 20 |
| Water Valley Miss. | red sand | 20 | 40 |
| (mailing address) | Clay and sand | 40 | 60 |
| | white sand | 60 | 170 |
| WELL LOCATION: | | | |
| sec. 25 T 12 N R 5 E S 3 W | | | |
| 4 miles west of Water Valley (distance) (direction) (nearest town) | | | |
| WELL PURPOSE: | | | |
| (home irrigation, municipal, industrial) | | | |
| WELL COMPLETION DATA: | | | |
| (1) diameter (inches) 4 | | | |
| (2) total depth (feet) 170 | | | |
| (3) static water level (feet) 125 below top of ground. | | | |
| (4) casing PVC 160 (material) (depth) | | | |
| 4 (size) if telescope see back. | | | |
| (5) screen 10 160 (length) (depth to top) | | | |
| 4 PVC (size) (material) | | | |
| (6) pump 3/4 12 (HP) (yield gpm) | | | |
| elec. (type power) | | | |
| (7) electric log NO (yes or no) | | | |
| NO (organization running log) | | | |
| (8) how well bottom plugged PVC PLUG | | | |
| DRILLERS REMARKS: | | | |
| | | | |

CODED

NOV 7 1973

If well telescopes please sketch and show depths.

GROUND LEVEL

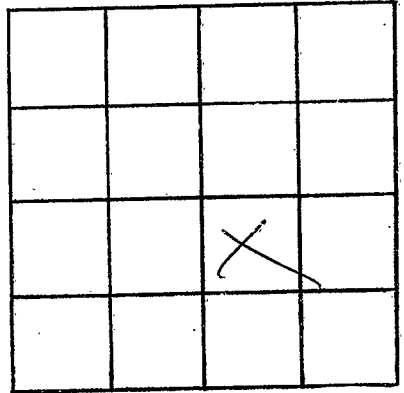

SECTION 25

Please indicate well location X.

ADDITIONAL INFORMATION

If more than one screen, show locations of each on sketch.