

YALO.

MISSISSIPPI BOARD OF WATER COMMISSIONERS

~~008~~  
3-1-66

B-43

WATER WELL DRILLERS LOG

EX-101

Date: B3-1, 1966, Driller: J B Cain County: Parola  
(Name)

|  | Description & Color of Materials<br>Sand, Clay, Red Clay, Shell, etc. | Thick-<br>ness<br>Feet | Depth<br>Feet         |
|--|---|------------------------|-----------------------|
| (1) Owner of Land: <u>James Seldford</u><br>(Name)<br><u>Coffeulle Miss</u><br>(Address)   | clay  | 0                      | 10                    |
| (2) Location: $\frac{1}{4}$ , <u>1-25-6</u> Sec. <u>P. R.</u><br><u>10</u> miles <u>N</u> of <u>Coffeulle</u><br>(distance) (direction) (Nearest Town) | sand, clay<br>clay<br>sand clay<br>sand                               | 10<br>30<br>50<br>80   | 30<br>50<br>80<br>120 |
| (3) Topography: <u>✓</u><br>(Hilly) (Flat) (Level)   |   |                        |                       |
| (4) Purpose of Well:<br>(Domestic Irrigation<br>Municipal, Industrial, Other)  |   |                        |                       |


Information upon completion of well:

- (1) Diameter 2 inches.
- (2) Total Depth 120 feet.
- (3) Water Level 80 feet below top of ground.
- (4) Cased to 120, Size 2"
- (5) Screen: Size 3 g<sup>no</sup>, Length 5 FT
- (6) Were any formations sealed against pollution?  
\_\_\_\_\_ yes, \_\_\_\_\_ no.

If YES depth of formation \_\_\_\_\_

Why \_\_\_\_\_

Drillers Remarks: 2" plastic

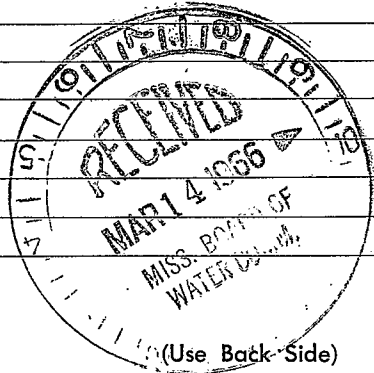

Well No.

100

100

100

100