

YALO.

MISSISSIPPI BOARD OF WATER COMMISSIONERS

CODED

~~C#~~ B-44
10-12-65

WATER WELL DRILLERS LOG

CODED

Date: 10-12, 1965, Driller: Jerry Peterson County Panama
(Name)

(1) Owner of Land: Charles Dowkins
(Name)
Coffeyville, Miss
(Address)

(2) Location: 1/4, 25 25 T 6R
8 miles N, of Coffeyville
(distance) (direction) (Nearest Town)

(3) Topography: V
(Hilly) (Flat) (Level)

(4) Purpose of Well: Home
(Domestic Irrigation
Municipal, Industrial, Other)

Description & Color of Materials Sand, Clay, Red Clay, Shell, etc.	Thick- ness Feet	Depth Feet
Clay	0	20
Sandy Clay	20	50
Clay	50	220
Sand	220	348

Information upon completion of well:

(1) Diameter 2 inches.

(2) Total Depth 348 feet.

(3) Water Level 60 feet below top of ground.

(4) Cased to 168, Size 2 in

(5) Screen: Size open bottom, length


(6) Were any formations sealed against pollution?

yes, no.

If YES depth of formation

Why

Drillers Remarks: Plastic Well

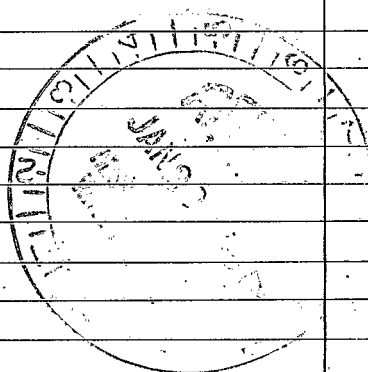

(Use Back Side)

Well No.

[The page contains extremely faint and illegible text, likely bleed-through from the reverse side of the document. No specific words or phrases can be discerned.]